REGAN YOUNG ENGLAND BUTERA

REFERENDUMS • ENGINEERING • ARCHITECTURE • DESIGN





ADDENDUM - 01

DATE: 26 September 2023 **FROM:** Patrick Farmer, AIA

VIA: Addendum Notification Fax & E-Mail

SUBJECT:
ADDENDUM #1
AUDITORIUM RENOVATION – F.W. HOLBEIN SCHOOL
RYEB Project #5733A

This addendum is issued to clarify, correct, or supplement the Documents as originally issued and will become a part of the Contract. Receipt thereof shall be acknowledged by Bidders in space provided in the Form of Bid. Failure to acknowledge this Addendum on the official Form of Bid may be cause for rejection of Bid.

- **1.01 AMENDED DRAWINGS**: Several drawings have been amended and are attached to this Addendum. The amended drawings supersede the originally issued drawings. Delete originally issued drawings and replace with the amended drawings listed under AMENDED DRAWINGS.
- **1.02 AMENDMENT**: (Reference to Section 002000, FORM OF BID): Delete Section 002000, FORM OF BID that was issued in the Project Manual. Replace with new Section 002000, FORM OF BID (AMENDED), consisting of 7 pages total. <u>BIDDERS MUST USE THE</u> AMENDED FORM OF BID WHEN SUBMITTING A BID.
- **1.03 AMENDMENT**: (Reference to Section 098433, SOUND-ABSORBING WALL UNITS): Delete Section 098433, SOUND-ABSORBING WALL UNITS that was issued in the Project Manual. Replace with new Section 098433, SOUND-ABSORBING WALL UNITS, consisting of 7 pages total. There was an error with the document header, which has been corrected. No other information was changed.
- **1.04 AMENDMENT**: (Reference to Section 028213, Removal and Disposal of Asbestos Containing Materials & Drawing HA1.01): The Contractor shall be permitted to conduct the asbestos abatement work during the District's Spring Break, which will take place from 03/29/2024 through 04/07/2024. The work shall be limited to the existing seating and flooring system abatement only. The removal of the doors and frames and other asbestos related work shall occur over the summer construction schedule.
- 1.05 AMENDMENT: (Reference to Specification Section, 090561.13 MOISTURE VAPOR EMISSION CONTROL): Delete Paragraph 1.3 in its entirety. The Unit Prices related to this Section has been deleted. This requirement has also been deleted from the original Specification Section 020000, FORM OF BID.

All concrete areas to receive new floor finishes, shall receive MEV-Control Systems over the entire concrete area to receive new floor finishes as part of the Base-Bid.

The Contractor shall confirm with the flooring finish manufacturers technical representatives that the selected flooring adhesives will have no adverse reactions to the MEV-Control system selected by the Contractor. The Contractor shall also follow the proper subfloor preparation per flooring manufacturers' written installation instructions, as well as MVEC manufacturer's install instructions to ensure warranty compliance of flooring and effective bond.

Bidders are required to use the attached Section 020000, FORM OF BID (Amended).

- **1.06 AMENDMENT**: (Reference to Systems Demonstration/Training): The Contractor shall videorecord all systems demonstration/trainings to the Owner.
- <u>1.07</u> <u>CLARIFICATION:</u> (Reference to New Aluminum Guardrails): The drawings and specifications require black anodized aluminum guardrails. Additionally, factory-coated black powder coat finish is also acceptable.
- 1.08 CLARIFICATION: (Reference to Hardware Set 1.0 in Specification Section 087100): The notes under hardware set states: "CARD READER BY SECURITY VENDOR. PRESENTING AUTHORIZED CREDENTIAL TO CARD READER OR INTERCOM BUZZER WILL UNLOCK EXIT DEVICE ALLOWING ACCESS. EGRESS IS BY EXIT DEVICE. EMERGENCY ACCESS BY KEY." There will be no intercom, only a card reader, as part of the sequence of entry operations.
- **1.09 AMENDMENT**: The Contractor must perform a ground-penetrating radar scan, or other acceptable method, of the existing slab to confirm no existing utilities (electrical, plumbing, etc.) are located in areas of existing slab to be saw-cut.
- **1.10 AMENDMENT**: The contractor shall provide one (1) Network GPIO Expander, QSC part number QIO-GP8x8, as part of the Audio-Visual Bill of Materials on Dwg E-200. This equipment shall be utilized to perform the muting of the auditorium sound system in the event of fire alarm system relay activation or a panic alarm system relay activation. Contractor shall provide all necessary wiring, all required supporting equipment/components, and programming to accommodate this sequence of operations.

1.11 DISTRICT VENDORS:

The District's Fire Alarm vendor is: ADT Richard J. Liebhauser 732-898-3919 RichardLiebhauser@adt.com

The District's Security/Access Control vendor is: Sonitrol
Bryan Bensel
609-304-5752
bryan@sonitrolnewjersey.com

ATTACHMENTS:

- 1. Amended Section 020000, FORM OF BID, consisting of 7 pages total.
- 2. Amended Section 098433, SOUND-ABSORBING WALL UNITS, consisting of 7 pages total.

AMENDED DRAWINGS:

- 1. Architectural Drawings: CS, A-101, A-102, A-103, A-104 & A-105.
- 2. Electrical Drawings: E-001 & E-102.

Including this document, Addendum 01 consists of 16 pages of text and 8 Drawings.

SECTION 002000 - FORM OF BID (AMENDED)
TO:
Evon DiGangi, Board Secretary/School Business Administrator MOUNT HOLLY TOWNSHIP BOARD OF EDUCATION 331 Levis Drive Mount Holly, New Jersey 08060
FROM:
(NAME)
(ADDRESS)
(CITY, STATE, ZIP)
(PHONE/FAX NUMBER)
(EMAIL ADDRESS)
Operating as an individual, a partnership, corporation under the laws of the State of New Jersey
(Input words that apply)
BID FOR: RYEBREAD PROJECT NO. 5733A
AUDITORIUM RENOVATION – F.W. HOLBEIN SCHOOL
333 Levis Drive
Mount Holly, New Jersey 08060
This Bid is based on Specifications and Drawings dated 07 August 2023, with Drawings revision date of 26 September 2023 and prepared by:
REGAN YOUNG ENGLAND BUTERA, PC
456 High Street
Mt. Holly, New Jersey 08060

1 **BASE-BID** 2 3 **BASE-BID:** Pursuant to and in compliance with your request for Bids for the above named project 4 and contract, and having examined the site where the work is to be located, and having become 5 familiar with local conditions as they may, in any way, affect the cost and/or execution of the work, and having carefully examined the specifications and drawings named above, the Undersigned 6 Bidder hereby agrees to provide all plant, labor, materials, supplies equipment, transportation and 7 8 other facilities necessary and proper for, or incidental to, or required for complete and satisfactory 9 execution of work. For a one-time lump sum bid, which shall include the allowance(s) and unit 10 price total(s): 11 12 13 Base-Bid: 14 (written amount) 15 16 17 **ALLOWANCES** 18 19 ALLOWANCES below, which include labor, materials, taxes, insurance, overhead, profit and 20 other costs in connection therewith, shall be included in the Base-Bid proposal for the quantities 21 listed. Allowances listed shall include all incidental items required to render the allowance fully 22 complete and operational whether specifically referenced or not. Any unused allowances shall be 23 deducted from the contract value at the stated amount. 24 25 Contingency Allowance No. 01: Include in the Base-Bid a contingency allowance amount of \$50,000 (fifty thousand dollars and no cents) for additional work, as allowed by applicable law, 26 27 and as directed by the Architect and approved by the Owner. 28 29 **ALTERNATES** 30 31 ALTERNATE BIDS below to be executed by the Undersigned Bidder in accordance with the Specifications and Drawings for the Addition to (ADD) to the Base Bid as follows. 32 33 34 All costs listed for each alternate shall include costs of related coordination, revision, or adjustment. 35 36 All Prime Bidders shall complete the schedule for each Alternate Bid. If the Alternate Bid does 37 not pertain to a particular trade or if there is no cost associated with the Alternate, input "No Dollar 38 Change" in that space. Prime Bidders shall be required to bid on all alternates listed under their 39 contract Alternate Bids. 40 41 Note: Owner reserves the right to select from any listed Alternate as deemed in the best interest 42 of the Mount Holly Board of Education, in accordance with applicable law. 43 44 45

shown on the drawings and a	as specified. For a lump sum total of:	
	(ADD)	
	(\$	cal amount)
(written amount)	(numeric	cal amount)
Provide and install cyclorar	EYCLORAMA CURTAIN, RIGGING, & LIGHTI ma curtain and associated rigging and cyclorama liging of fixtures. For a lump sum total of:	
	(ADD)	
	(\$_	
written amount)	(numeric	cal amount)
ncluded the removal and re-	with new specified acoustical panel ceilings and grid installation of all existing ceiling-mounted componen	
included the removal and re-		
ncluded the removal and resum total of:	installation of all existing ceiling-mounted componen (ADD)	its. For a lum
ncluded the removal and resum total of:	installation of all existing ceiling-mounted componen (ADD)	
(written amount) HOLD HARMLESS AGR corporation, also responsible agrees to indemnify and ho agents and employees, from reasonable attorney's fees in illness or death, or for proper omission or that of a Subcontractor or subcontractor reinstances whether Owner, A	(ADD) (\$\frac{\sqrt{\text{NDD}}}{\text{(numerical}}}\$ EEMENT: By submitting and executing a bid, a individual of corporation signing individually and a ld harmless the Owner, Construction Manager, Archall and against all claims, damages, losses, and expectase it shall be necessary to file an action, arising out of the try damage, by the Contractor negligent, reckless or into ontractor, or that of anyone employed by them or may be liable. This indemnification and agreement sharchitect is made a party to the action by third-party into arising, in whole or in part, from any of the issues of the state of the st	the Bidder, s a partnershinitect, and the enses, including bodily injurtentional acts for whose achall apply in an-pleading or

2			ay be cause for rejection of bid.).
3 4			DOCUMENTS ACCOMPANYING BID
5 6 7 8 9	disqu	ıalificatio	vide all required documents and required number of copies may be cause for on and rejection of bid. Documents referenced as "Mandatory Documents" itted with the Bid.
10 11 12	Bio		ecklist: Bidder should submit the following required documents in the order isted below & place an "X" in the box next to each item provided.
13 14	1.		Form of Bid. Section 002000. (Mandatory Document).
15 16 17	2.		New Jersey DPMC Notice of Contractor Classification, in accordance with N.J.S.A. 18A:18A-26 et seq. and N.J.S.A 18A:18A-32. (Mandatory Document).
18 19 20 21	3.		New Jersey DPMC Total Amount of Uncompleted Contracts (DPMC Form 701), in accordance with N.J.S.A. 18A:18A-26 et seq. and N.J.S.A 18A:18A-32. (Mandatory Document).
22 23 24 25 26 27	4.		Bid Guarantee in the form of a Bid Bond, certified check or cashier's check in the amount of 10% of the Base Bid, but in any event not more than \$20,000.00. The Bid Security must be in a form consistent with the statutory requirements of the State of New Jersey, in accordance with N.J.S.A. 18A:18A-24. (Mandatory Document).
28 29 30	5.		Consent of Surety: Section 002800, or similar, in accordance with N.J.S.A. 18A:18A-25. (Mandatory Document).
31	6.		Surety Company & Agency Information: Section 002801.
33 34 35	7.		Ownership Disclosure Statement: Section 002900, in accordance with N.J.S.A 52:25-24.2. (Mandatory Document).
36 37	8.		Non-Collusion Affidavit: Section 002950.
38 39 40	9.		No Material Change of Circumstances: Section 002960, in accordance with N.J.S.A. 18A:18A-26 et seq. and N.J.S.A 18A:18A-32. (Mandatory Document).
41 42	10.		Contractor's Sworn Contractor Certification. Section 004580.

701). (Mandatory Document). C. No Material Change of Circumstances: Section 002960. (Man Document). D. Contractor's Sworn Contractor Certification. Section 004580 Credentials 1, and 2 listed below must be stapled to this certification. 1. Business Registration Certificate issued by the Departm Treasury. 1. Business Registration Certificate issued by the Departm Treasury. 2. Contractor or trade license. (Not applicable for General Contractor or Structural Steel). E. Evidence of listed trade Subcontractor's performance security (Required only if Bidders Bid Bond does not cover Bidders Prosubcontractors.) (Attach to Prime Bidder's Bid Bond). ONE (1) Copy of all required documents. ONE (1) Copy of all required documents. DOCUMENTS SHOULD BE PROVIDED BY THE SUCCESSFUL BIDDERS PRINT THE AWARD OF CONTRACT Documents referenced as "Mandatory Documents" must be submitted prior to the Athe Contract. 1. Public Works Contractor Registration Certificate from the New Jersey Department or in accordance with the "Public Works Contractor Registration Act", in accordance with N.J.S.A. 34:11-56.48 et seq. (Mandatory Document). 2. Federal Debarment Certification: Form of certification stating that bidder is not contractor of the Station of Taxation, in accordance with N.J.S.A. 52:32-44. (Mandatory Document).	1 2	11.	List of Listed Trade Subcontractors: Section 005290, in accordance with N.J.S.A.18A:18A-18. (Mandatory Document).
B. Total Amount of Uncompleted Contracts Affidavit (DPMC 701). (Mandatory Document). C. No Material Change of Circumstances: Section 002960. (Man Document). D. Contractor's Sworn Contractor Certification. Section 004580 Credentials 1, and 2 listed below must be stapled to this certificate issued by the Departm Treasury. 1. Business Registration Certificate issued by the Departm Treasury. 2. Contractor or trade license. (Not applicable for General Contractor or Structural Steel). E. Evidence of listed trade Subcontractor's performance security (Required only if Bidders Bid Bond does not cover Bidders Proceed and Proceedings of the Contractor.) (Attach to Prime Bidder's Bid Bond). ONE (1) Copy of all required documents. DOCUMENTS SHOULD BE PROVIDED BY THE SUCCESSFUL BIDDERS PRIME THE AWARD OF CONTRACT Documents referenced as "Mandatory Documents" must be submitted prior to the A the Contract. 1. Public Works Contractor Registration Certificate from the New Jersey Department of in accordance with the "Public Works Contractor Registration Act", in accordance with N.J.S.A. 34:11-56.48 et seq. (Mandatory Document). 2. Federal Debarment Certification: Form of certification stating that bidder is not contractor of the Contractor of the New Jersey Division of Tax accordance with N.J.S.A. 52:32-44. (Mandatory Document). 3. Business Registration Certificate from the New Jersey Division of Tax accordance with N.J.S.A. 52:32-44. (Mandatory Document).	3		For each listed trade subcontractor, attached a copy of:
C. No Material Change of Circumstances: Section 002960. (Mar Document). D. Contractor's Sworn Contractor Certification. Section 004580 Credentials 1, and 2 listed below must be stapled to this certification. 1. Business Registration Certificate issued by the Departm Treasury. 2. Contractor or trade license. (Not applicable for General Contractor or Structural Steel). E. Evidence of listed trade Subcontractor's performance security (Required only if Bidders Bid Bond does not cover Bidders Prosubcontractors.) (Attach to Prime Bidder's Bid Bond). ONE (1) Copy of all required documents. ONE (1) Copy of all required documents. DOCUMENTS SHOULD BE PROVIDED BY THE SUCCESSFUL BIDDERS PROVIDED BY THE SUCCESS	5		B. Total Amount of Uncompleted Contracts Affidavit (DPMC Form
Credentials 1, and 2 listed below must be stapled to this certificate 1. Business Registration Certificate issued by the Departm Treasury. 1. Business Registration Certificate issued by the Departm Treasury. 2. Contractor or trade license. (Not applicable for General Contractor or Structural Steel). 1. E. Evidence of listed trade Subcontractor's performance security (Required only if Bidders Bid Bond does not cover Bidders Prosubcontractors.) (Attach to Prime Bidder's Bid Bond). 12. ONE (1) Copy of all required documents. 13. DOCUMENTS SHOULD BE PROVIDED BY THE SUCCESSFUL BIDDERS PRIME THE AWARD OF CONTRACT 14. Documents referenced as "Mandatory Documents" must be submitted prior to the A the Contract. 15. Public Works Contractor Registration Certificate from the New Jersey Department of in accordance with the "Public Works Contractor Registration Act", in accordance with N.J.S.A. 34:11-56.48 et seq. (Mandatory Document). 16. Documents referenced as "Mandatory Documents" must be submitted prior to the A the Contract. 17. Public Works Contractor Registration Certificate from the New Jersey Department of in accordance with N.J.S.A. 34:11-56.48 et seq. (Mandatory Document). 18. Documents referenced as "Mandatory Documents" must be submitted prior to the A the Contract. 19. Public Works Contractor Registration Act", in accordance with N.J.S.A. 32:32-44.1. Section (Mandatory Document). 19. Section of Contractor Registration of Public Contractors from the New Jersey Division of Tax accordance with N.J.S.A. 52:32-44. (Mandatory Document). 19. Business Registration Certificate from the New Jersey Division of Taxation, in accordance with N.J.S.A. 52:32-44, and the Public Works Contractor Registration Certificate from the New Jersey Division of Taxation, in accordance with N.J.S.A. 52:32-44, and the Public Works Contractor Registration Certificate from the New Jersey Division of Taxation, in accordance with N.J.S.A. 52:32-44, and the Public Works Contractor Registration Certificate from the New Jersey Divis	7 8		C. No Material Change of Circumstances: Section 002960. (Mandatory Document).
1. Business Registration Certificate issued by the Departm Treasury. 2. Contractor or trade license. (Not applicable for General Contractor or Structural Steel). E. Evidence of listed trade Subcontractor's performance security (Required only if Bidders Bid Bond does not cover Bidders Pr subcontractors.) (Attach to Prime Bidder's Bid Bond). ONE (1) Copy of all required documents. DOCUMENTS SHOULD BE PROVIDED BY THE SUCCESSFUL BIDDERS PRIOR THE AWARD OF CONTRACT Documents referenced as "Mandatory Documents" must be submitted prior to the A the Contract. Public Works Contractor Registration Certificate from the New Jersey Department of in accordance with the "Public Works Contractor Registration Act", in accordance with N.J.S.A. 34:11-56.48 et seq. (Mandatory Document). Federal Debarment Certification: Form of certification stating that bidder is not of debarred, suspended or disqualified under N.J.S.A. 52:32-44.1. Section of (Mandatory Document). Business Registration of Public Contractors from the New Jersey Division of Tax accordance with N.J.S.A. 52:32-44. (Mandatory Document). Business Registration Certificate from the New Jersey Division of Taxation, in accordance with N.J.S.A. 52:32-44, and the Public Works Contractor Registration Certificate from the New Jersey Division of Taxation, in accordance with N.J.S.A. 52:32-44, and the Public Works Contractor Registration Certificate from the New Jersey Division of Taxation, in accordance with N.J.S.A. 52:32-44, and the Public Works Contractor Registration Certificate from the New Jersey Division of Taxation, in accordance with N.J.S.A. 52:32-44, and the Public Works Contractor Registration Certificate from the New Jersey Division of Taxation, in accordance with N.J.S.A. 52:32-44, and the Public Works Contractor Registration Certificate from the New Jersey Division of Taxation, in accordance with N.J.S.A. 52:32-44, and the Public Works Contractor Registration Certificate from the New Jersey Division of Taxation, in accordance with N.J.S.A. 52:32-44, and t	10		
1. Business Registration Certificate issued by the Departm Treasury. 2. Contractor or trade license. (Not applicable for General Contractor or Structural Steel). E. Evidence of listed trade Subcontractor's performance security (Required only if Bidders Bid Bond does not cover Bidders Provided Strategies and Strategies Strategi			Credentials 1, and 2 listed below must be stapled to this certification.
Contractor or Structural Steel). E. Evidence of listed trade Subcontractor's performance security (Required only if Bidders Bid Bond does not cover Bidders Prosubcontractors.) (Attach to Prime Bidder's Bid Bond). ONE (1) Copy of all required documents. ONE (1) Copy of all required documents. DOCUMENTS SHOULD BE PROVIDED BY THE SUCCESSFUL BIDDERS PRICE THE AWARD OF CONTRACT Documents referenced as "Mandatory Documents" must be submitted prior to the A the Contract. Public Works Contractor Registration Certificate from the New Jersey Department of in accordance with the "Public Works Contractor Registration Act", in accordance with N.J.S.A. 34:11-56.48 et seq. (Mandatory Document). Federal Debarment Certification: Form of certification stating that bidder is not condebarred, suspended or disqualified under N.J.S.A. 52:32-44.1. Section (Mandatory Document). Business Registration of Public Contractors from the New Jersey Division of Taxation, in accordance with N.J.S.A. 52:32-44. (Mandatory Document). Business Registration Certificate from the New Jersey Division of Taxation, in accordance with N.J.S.A. 52:32-44, and the Public Works Contractor Registration Certificate from the New Jersey Division of Taxation, in accordance with N.J.S.A. 52:32-44, and the Public Works Contractor Registration Certificate from the New Jersey Division of Taxation, in accordance with N.J.S.A. 52:32-44, and the Public Works Contractor Registration Certificate from the New Jersey Division of Taxation, in accordance with N.J.S.A. 52:32-44, and the Public Works Contractor Registration Certificate from the New Jersey Division of Taxation, in accordance with N.J.S.A. 52:32-44, and the Public Works Contractor Registration Certificate from the New Jersey Division of Taxation, in accordance with N.J.S.A. 52:32-44, and the Public Works Contractor Registration Certificate from the New Jersey Division of Taxation, in accordance with N.J.S.A. 52:32-44, and the Public Works Contractor Registration Certificate from the New Jersey Division of	13		
(Required only if Bidders Bid Bond does not cover Bidders Prisubcontractors.) (Attach to Prime Bidder's Bid Bond). 12. ONE (1) Copy of all required documents. DOCUMENTS SHOULD BE PROVIDED BY THE SUCCESSFUL BIDDERS PRINTED AWARD OF CONTRACT Documents referenced as "Mandatory Documents" must be submitted prior to the A the Contract. Public Works Contractor Registration Certificate from the New Jersey Department of in accordance with the "Public Works Contractor Registration Act", in accordance with N.J.S.A. 34:11-56.48 et seq. (Mandatory Document). Federal Debarment Certification: Form of certification stating that bidder is not of debarred, suspended or disqualified under N.J.S.A. 52:32-44.1. Section (Mandatory Document). Business Registration of Public Contractors from the New Jersey Division of Tax accordance with N.J.S.A. 52:32-44. (Mandatory Document). Business Registration Certificate from the New Jersey Division of Taxation, in accordance with N.J.S.A. 52:32-44, and the Public Works Contractor Registration Ce			\ \ \ \ \ \ \ \ \ \ \ \ \ \ \ \ \ \ \
DOCUMENTS SHOULD BE PROVIDED BY THE SUCCESSFUL BIDDERS PRIOR THE AWARD OF CONTRACT Documents referenced as "Mandatory Documents" must be submitted prior to the A the Contract. Public Works Contractor Registration Certificate from the New Jersey Department of in accordance with the "Public Works Contractor Registration Act", in accordance with N.J.S.A. 34:11-56.48 et seq. (Mandatory Document). Federal Debarment Certification: Form of certification stating that bidder is not condebarred, suspended or disqualified under N.J.S.A. 52:32-44.1. Section (Mandatory Document). Business Registration of Public Contractors from the New Jersey Division of Tax accordance with N.J.S.A. 52:32-44. (Mandatory Document). Business Registration Certificate from the New Jersey Division of Taxation, in accordance with N.J.S.A. 52:32-44, and the Public Works Contractor Registration Certificate Registration Registrati	18		(Required only if Bidders Bid Bond does not cover Bidders Prime
DOCUMENTS SHOULD BE PROVIDED BY THE SUCCESSFUL BIDDERS PRICE THE AWARD OF CONTRACT Documents referenced as "Mandatory Documents" must be submitted prior to the A the Contract. Public Works Contractor Registration Certificate from the New Jersey Department of in accordance with the "Public Works Contractor Registration Act", in accordance with N.J.S.A. 34:11-56.48 et seq. (Mandatory Document). Federal Debarment Certification: Form of certification stating that bidder is not condebarred, suspended or disqualified under N.J.S.A. 52:32-44.1. Section (Mandatory Document). Business Registration of Public Contractors from the New Jersey Division of Tax accordance with N.J.S.A. 52:32-44. (Mandatory Document). Business Registration Certificate from the New Jersey Division of Taxation, in accordance with N.J.S.A. 52:32-44, and the Public Works Contractor Registration Certificate Registration R		12.	ONE (1) Copy of all required documents.
Documents referenced as "Mandatory Documents" must be submitted prior to the A the Contract. 1. Public Works Contractor Registration Certificate from the New Jersey Department of in accordance with the "Public Works Contractor Registration Act", in accordance with N.J.S.A. 34:11-56.48 et seq. (Mandatory Document). 2. Federal Debarment Certification: Form of certification stating that bidder is not of debarred, suspended or disqualified under N.J.S.A. 52:32-44.1. Section (Mandatory Document). 3. Business Registration of Public Contractors from the New Jersey Division of Tax accordance with N.J.S.A. 52:32-44. (Mandatory Document). 4. Business Registration Certificate from the New Jersey Division of Taxation, in accordance with N.J.S.A. 52:32-44, and the Public Works Contractor Registration Certificate from the New Jersey Division of Taxation, in accordance with N.J.S.A. 52:32-44, and the Public Works Contractor Registration Certificate from the New Jersey Division of Taxation, in accordance with N.J.S.A. 52:32-44, and the Public Works Contractor Registration Certificate from the New Jersey Division of Taxation, in accordance with N.J.S.A. 52:32-44, and the Public Works Contractor Registration Certificate from the New Jersey Division of Taxation, in accordance with N.J.S.A. 52:32-44, and the Public Works Contractor Registration Certificate from the New Jersey Division of Taxation, in accordance with N.J.S.A. 52:32-44, and the Public Works Contractor Registration Certificate from the New Jersey Division of Taxation, in accordance with N.J.S.A. 52:32-44, and the Public Works Contractor Registration Certificate from the New Jersey Division of Taxation, in accordance with N.J.S.A. 52:32-44, and the Public Works Contractor Registration Certificate from the New Jersey Division of Taxation, in accordance with N.J.S.A. 52:32-44, and the Public Works Contractor Registration Certificate from the New Jersey Division of Taxation Certificate from the New Jersey Division of Taxation Certificate from the New Jersey Division	22 23	DO	CUMENTS SHOULD BE PROVIDED BY THE SUCCESSFUL BIDDERS PRIOR TO
Documents referenced as "Mandatory Documents" must be submitted prior to the A the Contract. 1. Public Works Contractor Registration Certificate from the New Jersey Department of in accordance with the "Public Works Contractor Registration Act", in accordance with N.J.S.A. 34:11-56.48 et seq. (Mandatory Document). 2. Federal Debarment Certification: Form of certification stating that bidder is not of debarred, suspended or disqualified under N.J.S.A. 52:32-44.1. Section (Mandatory Document). 3. Business Registration of Public Contractors from the New Jersey Division of Tax accordance with N.J.S.A. 52:32-44. (Mandatory Document). 4. Business Registration Certificate from the New Jersey Division of Taxation, in accordance with N.J.S.A. 52:32-44, and the Public Works Contractor Registration Ce	24 25		THE AWARD OF CONTRACT
in accordance with the "Public Works Contractor Registration Act", in accordance with N.J.S.A. 34:11-56.48 et seq. (Mandatory Document). Federal Debarment Certification: Form of certification stating that bidder is not condebarred, suspended or disqualified under N.J.S.A. 52:32-44.1. Section (Mandatory Document). Business Registration of Public Contractors from the New Jersey Division of Tax accordance with N.J.S.A. 52:32-44. (Mandatory Document). Business Registration Certificate from the New Jersey Division of Taxation, in accordance with N.J.S.A. 52:32-44, and the Public Works Contractor Registration Certificate from the New Jersey Division of Taxation, in accordance with N.J.S.A. 52:32-44, and the Public Works Contractor Registration Certificate from the New Jersey Division of Taxation, in accordance with N.J.S.A. 52:32-44, and the Public Works Contractor Registration Certificate from the New Jersey Division of Taxation, in accordance with N.J.S.A. 52:32-44, and the Public Works Contractor Registration Certificate from the New Jersey Division of Taxation, in accordance with N.J.S.A. 52:32-44, and the Public Works Contractor Registration Certificate from the New Jersey Division of Taxation, in accordance with N.J.S.A. 52:32-44, and the Public Works Contractor Registration Certificate from the New Jersey Division of Taxation, in accordance with N.J.S.A. 52:32-44, and the Public Works Contractor Registration Certificate from the New Jersey Division of Taxation, in accordance with N.J.S.A. 52:32-44, and the Public Works Contractor Registration Certificate from the New Jersey Division of Taxation, in accordance with N.J.S.A. 52:32-44, and the Public Works Contractor Registration Certificate from the New Jersey Division of Taxation Certificate from t	26		iments referenced as "Mandatory Documents" must be submitted prior to the Award of ontract.
 Federal Debarment Certification: Form of certification stating that bidder is not c debarred, suspended or disqualified under N.J.S.A. 52:32-44.1. Section (Mandatory Document). Business Registration of Public Contractors from the New Jersey Division of Tax accordance with N.J.S.A. 52:32-44. (Mandatory Document). Business Registration Certificate from the New Jersey Division of Taxation, in account of N.J.S.A. 52:32-44, and the Public Works Contractor Registration Certificate from the New Jersey Division of Taxation. 	29 30	1.	Public Works Contractor Registration Certificate from the New Jersey Department of Labor in accordance with the "Public Works Contractor Registration Act", in accordance with N.J.S.A. 34:11-56.48 et seq. (Mandatory Document).
36 3. Business Registration of Public Contractors from the New Jersey Division of Tax accordance with N.J.S.A. 52:32-44. (Mandatory Document). 38 39 4. Business Registration Certificate from the New Jersey Division of Taxation, in accordance with N.J.S.A. 52:32-44, and the Public Works Contractor Registration Ce	32 33 34	2.	Federal Debarment Certification: Form of certification stating that bidder is not currently debarred, suspended or disqualified under N.J.S.A. 52:32-44.1. Section 002970. (Mandatory Document).
Business Registration Certificate from the New Jersey Division of Taxation, in acceedate with N.J.S.A. 52:32-44, and the Public Works Contractor Registration Ce	36 37	3.	Business Registration of Public Contractors from the New Jersey Division of Taxation in accordance with N.J.S.A. 52:32-44. (Mandatory Document).
	39 40	4.	Business Registration Certificate from the New Jersey Division of Taxation, in accordance with N.J.S.A. 52:32-44, and the Public Works Contractor Registration Certificate from the New Jersey Department of Labor in accordance with the "Public Works"

1 2 3		Contractor Registration Act", in accordance with N.J.S.A. 34:11-56.48 et seq. of the Listed Trade Subcontractors. (Mandatory Document).
4 5 6	5.	Prevailing Wage Rates Certification: Section 004595, in accordance with P.L. 2021, c.301; A4869 and S2414.
7 8	6.	Political Contribution Disclosure Form: Section 004590, in accordance with N.J.S.A. 19:44A-20.26. (Mandatory Document).
9 10 11 12	7.	Disclosure of Investment Activities in Iran Form: Section 004597, in accordance with N.J.S.A. 52:32-57. (Mandatory Document).
13 14 15 16 17		DOCUMENTS TO BE PROVIDED BY THE SUCCESSFUL BIDDER AFTER THE NOTICE OF AWARD AND PRIOR TO THE EXECUTION OF THE CONTRACT
18 19 20 21	1.	Affirmative Action Evidence for Construction Projects & Mandatory Equal Opportunity Language: Section 002850, in accordance with N.J.S.A 10:5-32 et seq. and N.J.A.C. 17:27-3.1 and N.J.A.C. 17:27-6.2.
22 23 24 25 26	to fu	WARDED CONTRACT, the Undersigned Bidder agrees to execute the AGREEMENT and arnish the required Performance and Payment Bonds and evidence of required insurance as soon racticable after Notice of Acceptance of bid or in any event not later than 10 calendar days after ipt of such notification.
27 28 29 30	of ir	e Undersigned Bidder fails to execute AGREEMENT and furnish required bond and evidence is surance, the Bid Security accompanying this Bid will be forfeited to the Owner as liquidated ages for the delay and loss caused to the Owner by reason of such failure by the Undersigned der.
31 32 33 34 35	and	E UNDERSIGNED BIDDER HAS COMPLIED with all requirements concerning licensing with all Local, State and Federal laws. No legal requirement has been violated in making this nor will be violated in the execution of the Work if this Bid is accepted.
36 37 38 39	qual	ddition, the undersigned hereby certifies that there has been no material adverse change in the ification information last submitted to the New Jersey Department of Treasury pursuant to S.A. 18A:18A-28.
40 41 42 43	A C unle	ARD OF CONTRACT ontract shall be awarded for all of the work and materials required to complete the project, ss all bids are rejected, to the lowest responsible bidder based on the total amount of the Base and Alternates (if any), accepted by the Owner.
44 45 46		S AGREED THAT THIS BID MAY NOT BE WITHDRAWN for a period of 60 days after the al date of receipt of bids.

47

date):		
ADDENDUM NO. DATED	ADDENDUM NO.	<u>DATED</u>
Check box if no Addendum		
Respectfully submitted this		20
		(Name o
`	By: Print	
*(SEAL IF BIDDER IS A CORPORATION)	By:	

SECTION 098433 - SOUND-ABSORBING WALL UNITS (AMENDED)

PART 1 - GENERAL

1.1 RELATED DOCUMENTS

A. Drawings and general provisions of the Contract, including General and Supplementary Conditions and Division 01 Specification Sections, apply to this Section.

1.2 SUMMARY

- A. Section includes shop-fabricated, impact-resistant acoustical panel units tested for acoustical performance, including the following:
 - 1. Sound-absorbing wall panels.

1.3 DEFINITIONS

- A. NRC: Noise Reduction Coefficient.
- B. SAA: Sound Absorption Average.

1.4 PREINSTALLATION MEETINGS

A. Preinstallation Conference: Conduct conference at Project site.

1.5 ACTION SUBMITTALS

- A. Product Data: For each type of product.
 - 1. Include fabric facing, panel edge, core material, and mounting indicated.
- B. Sustainable Design Submittals.
- C. Shop Drawings: For unit assembly and installation.
 - 1. Include plans, elevations, sections, and mounting devices and details.
 - 2. Include details at panel head, base, joints, and corners; and details at ceiling, floor base, and wall intersections. Indicate panel edge profile and core materials.
 - 3. Include details at cutouts and penetrations for other work.
 - 4. Include direction of fabric weave and pattern matching.
- D. Samples for Initial Selection: For each type of fabric facing.

- 1. Include Samples of hardware and accessories involving color or finish selection.
- E. Samples for Verification: For the following products:
 - 1. Fabric: Full-width by approximately 36-inch- (900-mm-) long Sample, but not smaller than required to show complete pattern repeat, from dye lot to be used for the Work, and with specified treatments applied. Mark top and face of fabric.
 - 2. Panel Edge: 12-inch- (300-mm-) long Sample(s) showing each edge profile, corner, and finish.
 - 3. Core Material: 12-inch- (300-mm-) square Sample at corner.
 - 4. Mounting Devices: Full-size Samples.
 - 5. Assembled Panels: Approximately 36 by 36 inches (900 by 900 mm), including joints and mounting methods.

1.6 INFORMATIONAL SUBMITTALS

- A. Coordination Drawings: Elevations and other details, drawn to scale, on which the following items are shown and coordinated with each other, using input from installers of the items involved:
 - 1. Electrical outlets, switches, and thermostats.
 - 2. Items penetrating or covered by units including the following:
 - a. Lighting fixtures.
 - b. Air outlets and inlets.
 - c. Speakers.
 - d. Alarms.
- B. Product Certificates: For each type of unit.
- C. Sample Warranty: For manufacturer's special warranty.

1.7 CLOSEOUT SUBMITTALS

A. Maintenance Data: For each type of unit to include in maintenance manuals. Include fabric manufacturers' written cleaning and stain-removal instructions.

1.8 MAINTENANCE MATERIAL SUBMITTALS

- A. Furnish extra materials from same production run that match products installed and that are packaged with protective covering for storage and identified with labels describing contents.
 - 1. Fabric: For each fabric, color, and pattern installed, provide length equal to 10 percent of amount installed, but no fewer than 10 sq. yd. (9 sq. m), full width of bolt.
 - 2. Mounting Devices: Full-size units equal to 5 percent of amount installed, but no fewer than five devices, including unopened adhesives.

1.9 QUALITY ASSURANCE

- A. Mockups: Build mockups to verify selections made under Sample submittals, to demonstrate aesthetic effects, and to set quality standards for materials, fabrication, and installation.
 - 1. Build mockup of typical wall area 48 inches (1200 mm) wide by full height. Include intersection of wall and ceiling, corners, and perimeters.
 - 2. Approval of mockups does not constitute approval of deviations from the Contract Documents contained in mockups unless Architect specifically approves such deviations in writing.
 - 3. Subject to compliance with requirements, approved mockups may become part of the completed Work if undisturbed at time of Substantial Completion.

1.10 DELIVERY, STORAGE, AND HANDLING

- A. Comply with fabric and unit manufacturers' written instructions for minimum and maximum temperature and humidity requirements for shipment, storage, and handling.
- B. Deliver materials and units in unopened bundles and store in a temperature-controlled dry place with adequate air circulation.

1.11 FIELD CONDITIONS

- A. Environmental Limitations: Do not install units until spaces are enclosed and weathertight, wetwork in spaces is complete and dry, work at and above ceilings is complete, and ambient temperature and humidity conditions are maintained at the levels indicated for Project when occupied for its intended use.
- B. Lighting: Do not install units until a permanent level of lighting is provided on surfaces to receive the units.
- C. Air-Quality Limitations: Protect units from exposure to airborne odors, such as tobacco smoke, and install units under conditions free from odor contamination of ambient air.
- D. Field Measurements: Verify unit locations and actual dimensions of openings and penetrations by field measurements before fabrication, and indicate them on Shop Drawings.

1.12 WARRANTY

- A. Special Warranty: Manufacturer agrees to repair or replace units and components that fail in materials or workmanship within specified warranty period.
 - 1. Failures include, but are not limited to the following:
 - a. Acoustical performance.
 - b. Fabric sagging, distorting, or releasing from panel edge.
 - c. Warping of core.

2. Warranty Period: Two years from date of Substantial Completion.

PART 2 - PRODUCTS

2.1 MANUFACTURERS

A. Source Limitations: Obtain wall units specified in this Section from single source from single manufacturer.

2.2 PERFORMANCE REQUIREMENTS

- A. Fire-Test-Response Characteristics: Units shall comply with "Surface-Burning Characteristics" or "Fire Growth Contribution" Subparagraph below, or both, as determined by testing identical products by UL or another testing and inspecting agency acceptable to authorities having jurisdiction:
 - 1. Surface-Burning Characteristics: Comply with ASTM E84 or UL 723; testing by a qualified testing agency. Identify products with appropriate markings of applicable testing agency.
 - a. Flame-Spread Index: 25 or less.
 - b. Smoke-Developed Index: 450 or less.
 - 2. Fire Growth Contribution: Comply with acceptance criteria of local code and authorities having jurisdiction when tested according to NFPA 265 Method B Protocol or NFPA 286.

2.3 SOUND-ABSORBING WALL UNITS

- A. Sound-Absorbing Wall Panel: Manufacturer's standard panel construction consisting of facing material laminated to front face, edges, and back edge border of core or stretched over front face of edge-framed core and bonded or attached to edges and back of frame.
 - 1. Manufacturers: Subject to compliance with requirements, available manufacturers offering products that may be incorporated into the Work include, but are not limited to the following:
 - a. Acoustical Solutions; AlphaSorb.
 - b. Conwed; Respond HI.
 - c. Decoustics; CertainTeed Architectural Products; a Saint Gobain company; High Impact Resilient Acoustical Wall Panel.
 - d. Kinetics Noise Control, Inc.; High Impact HardSide.
 - e. Approved equal.
 - 2. Minimum Thickness: not less than 2-inches thick.

- 3. Composition: 0.85 minimum.
- 4. Panel Shape: Flat.
- 5. Mounting: Edge mounted with splines secured to substrate.
 - a. Finish Color at Exposed Edges: As selected by Architect from manufacturer's full range.
- 6. Mounting: Back mounted with manufacturer's standard adhesive, secured to substrate.
- 7. Core: Manufacturer's standard.
 - a. Core-Face Layer: Manufacturer's standard impact-resistant, acoustically transparent, copolymer sheet.
- 8. Edge Construction: Manufacturer's standard chemically hardened core with no frame.
- 9. Edge Profile: Chamfered (beveled).
- 10. Corner Detail in Elevation: Square with continuous edge profile indicated.
- 11. Reveals between Panels: reveals as selected by Architect from manufacturer's full range.
- 12. Facing Material: As selected by Architect from Manufacturer's full range.
- 13. Facing material Colors: As selected by Architect from Manufacturer's standards. Multiple colors and combinations may be selected.
- 14. Acoustical Performance: Sound absorption NRC of 0.85 minimum according to ASTM C423 for Type A mounting according to ASTM E795.
- 15. Nominal Overall Panel Thickness: 2-inch minimum.
- 16. Panel Width: As indicated on Drawings.
- 17. Panel Height: As indicated on Drawings.

2.4 MATERIALS

- A. Core Materials: Manufacturer's standard.
 - 1. Glass-Fiber Board: ASTM C612; of type standard with manufacturer; nominal density of 6 to 7 lb/cu. ft. (96 to 112 kg/cu. m), unfaced, and dimensionally stable, molded rigid board; and with maximum flame-spread and smoke-developed indexes of 25 and 50, respectively.
 - 2. Fire-Retardant Formed Plastic: Manufacturer's standard formed plastic with flame-spread index of 25 or less and smoke-developed index of 25 or less according to ASTM E84 or UL 723.
 - a. Fire-retardant panels made from softwood fibers, synthetic resins, and fire-retardant chemicals mixed together at time of panel manufacture to achieve flame-spread index of 25 or less and smoke-developed index of 200 or less per ASTM E84 or UL 723.
 - 3. Impact-Resistant, Acoustically Transparent, Copolymer Sheet for Face Layer: 1/16- to 1/8-inch- (1.6- to 3.2-mm-) thick layer of perforated, noncombustible, copolymer sheet laminated to face of core.

- 4. Wood and Plywood: Manufacturer's standard plywood or clear, vertical grain, straight, kiln-dried hardwood.
 - a. Fire-retardant treated by pressure process with a flame-spread index of 25 or less when tested according to ASTM E84 or UL 723, and with no evidence of significant progressive combustion when the test is extended an additional 20 minutes, and with the flame front not extending more than 10.5 feet (3.2 m) beyond the centerline of the burners at any time during the test.
 - 1) Treated material shall have a moisture content of 28 percent or less when tested according to ASTM D3201/D3201M at 92 percent relative humidity.
 - 2) Kiln-dry material after treatment to 19 percent or less for lumber and 15 percent or less for plywood.
- B. Facing Material: Fabric from same dye lot; color and pattern as selected by Architect from manufacturer's full range.
- C. Mounting Devices: Concealed on back of unit, recommended by manufacturer to support weight of unit, and as follows:
 - 1. Splines: Manufacturer's standard concealed metal or plastic splines that engage the kerfed edges of the unit, with other moldings and trim for interior corners, exterior corners, and exposed edges, with factory-applied finish on exposed items.
 - 2. Impaling Clips: Manufacturer's standard.
 - 3. Magnetic Strip or Devices: [Manufacturer's standard] <Insert requirement>.

2.5 FABRICATION

- A. Standard Construction: Use manufacturer's standard construction unless otherwise indicated; with facing material applied to face, edges, and back border of dimensionally stable core; and with rigid edges to reinforce panel perimeter against warpage and damage.
- B. Edge Hardening: For glass-fiber board cores, chemically harden core edges and areas of core where mounting devices are attached.
- C. Core-Face Layer: Evenly stretched over core face and edges and securely attached to core; free from puckers, ripples, wrinkles, or sags.
- D. Facing Material: Apply fabric facing fully covering visible surfaces of unit; with material stretched straight, on the grain, tight, square, and free from puckers, ripples, wrinkles, sags, blisters, seams, adhesive, or other visible distortions or foreign matter.
 - 1. Radius and Other Nonsquare Corners: Attach facing material so there are no seams or gathering of material.
 - 2. Fabrics with Directional or Repeating Patterns or Directional Weave: Mark fabric top and attach fabric in same direction so pattern or weave matches in adjacent units.
- E. Dimensional Tolerances of Finished Units: Plus or minus 1/16 inch (1.6 mm) for the following:

- 1. Thickness.
- 2. Edge straightness.
- 3. Overall length and width.
- 4. Squareness from corner to corner.
- 5. Chords, radii, and diameters.

PART 3 - EXECUTION

3.1 EXAMINATION

- A. Examine fabric, fabricated units, substrates, areas, and conditions for compliance with requirements, installation tolerances, and other conditions affecting unit performance.
- B. Proceed with installation only after unsatisfactory conditions have been corrected.

3.2 INSTALLATION

- A. Install units in locations indicated. Unless otherwise indicated, install units with vertical surfaces and edges plumb, top edges level and in alignment with other units, faces flush, and scribed to fit adjoining work accurately at borders and at penetrations.
- B. Comply with manufacturer's written instructions for installation of units using type of mounting devices indicated. Mount units securely to supporting substrate.
- C. Align fabric pattern and grain with adjacent units.

3.3 INSTALLATION TOLERANCES

- A. Variation from Plumb and Level: Plus or minus 1/16 inch (1.6 mm) in 48 inches (1200 mm), noncumulative.
- B. Variation of Joint Width: Not more than 1/16-inch (1.6-mm) variation from reveal line in 48 inches (1200 mm), noncumulative.


3.4 CLEANING

- A. Clip loose threads; remove pills and extraneous materials.
- B. Clean panels on completion of installation to remove dust and other foreign materials according to manufacturer's written instructions.

END OF SECTION 098433

AUDITORIUM RENOVATION

F.W. HOLBEIN SCHOOL 333 LEVIS DRIVE BLOCK 41.05, LOT 12.09 MOUNT HOLLY, BURLINGTON COUNTY, NJ 08060

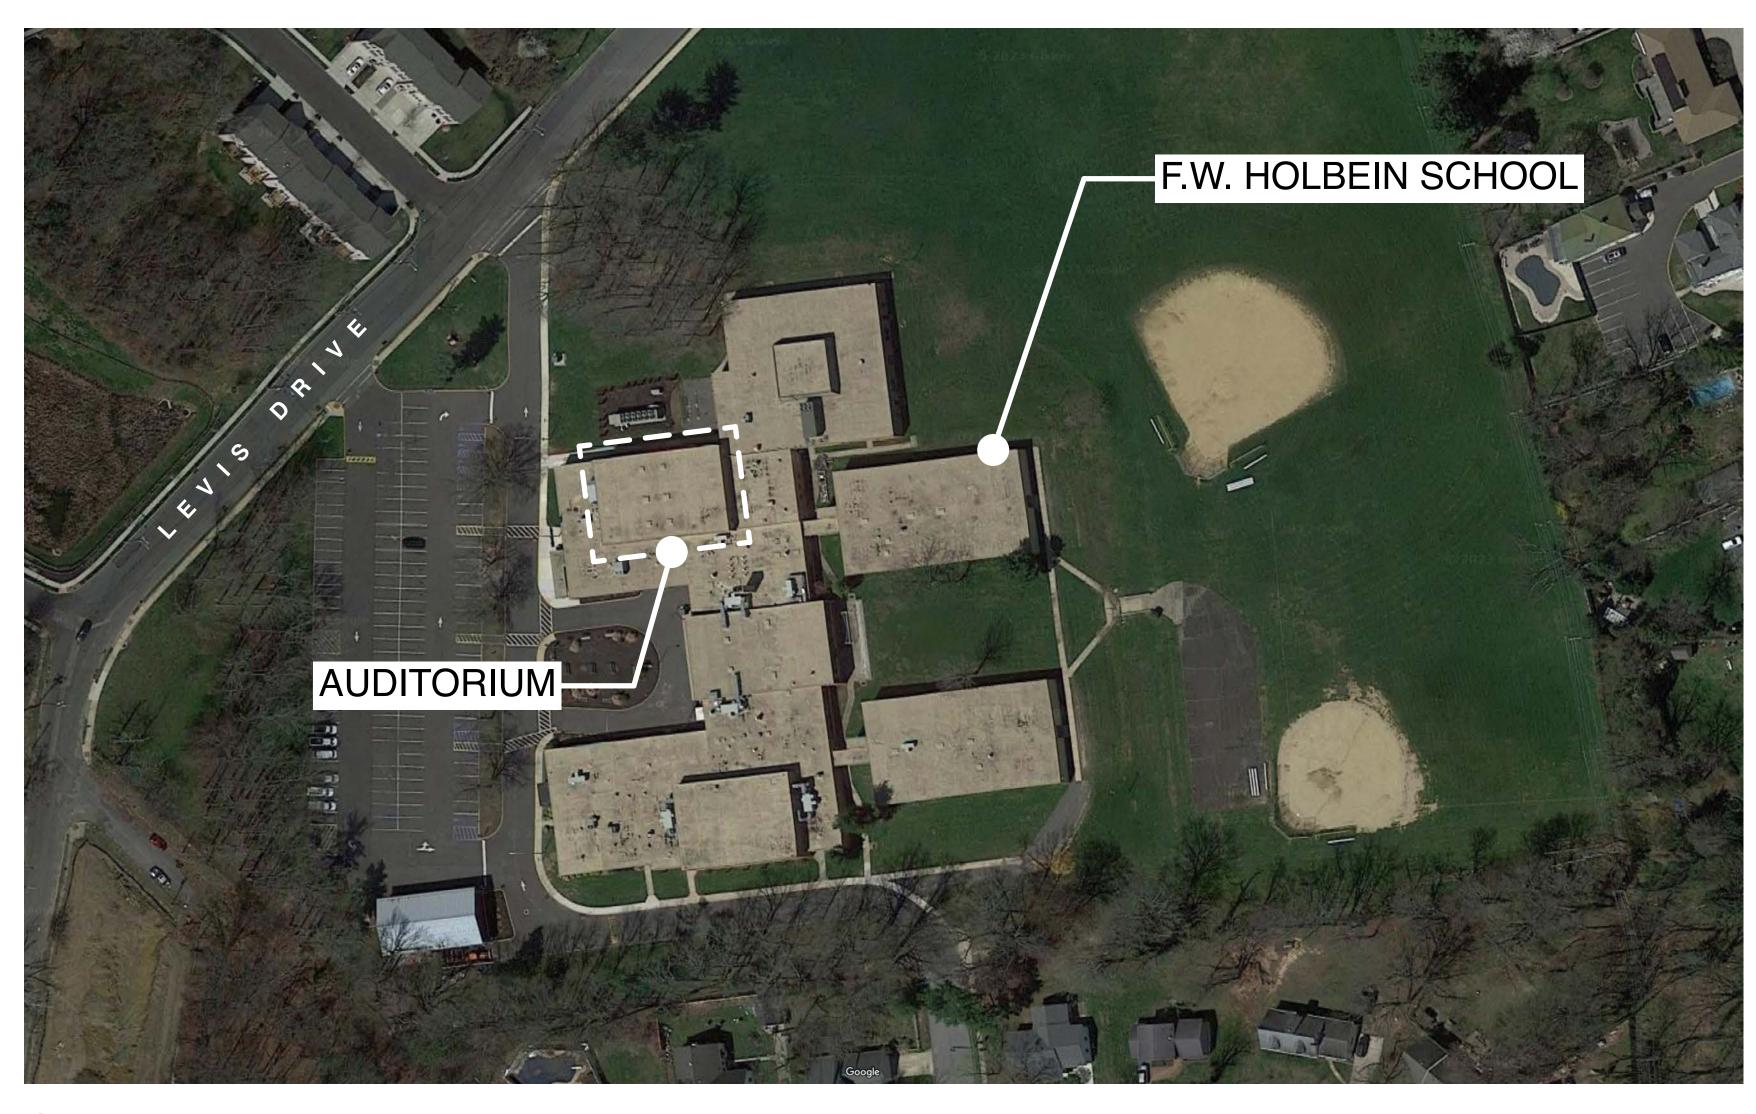

OWNER:

MOUNT HOLLY TOWNSHIP BOARD OF EDUCATION 331 LEVIS DRIVE MOUNT HOLLY, NJ 08060 609-267-7108 / 609-702-9082 FAX

ARCHITECT:

REGAN YOUNG ENGLAND BUTERA, PC 456 HIGH STREET MOUNT HOLLY, NJ 08060 609-265-2652 / 609-265-0333 FAX

ELECTRICAL:

SCHILLER & HERSH ASSOCIATES, INC 636 SKIPPACK PIKE SUITE 200 BLUE BELL, PA 19422 215-886-8947 / 215-886-8956 FAX

CONSTRUCTION MANAGER:

NEW ROAD CONSTRUCTION MANAGEMENT CO., INC. 1876 GREENTREE ROAD CHERRY HILL, NJ 08003 856-424-8888 / 856-424-1688 FAX

LIST OF DRAWINGS:

between different trades and/or for work included in other sections of the Project Manual that may pertain to their respective contract.

$\sim\sim\sim$

ARCHITECTURAL DRAWINGS

A-100 EGRESS PLAN A-101 DEMOLITION PLANS & INTERIOR ELEVATIONS

A-102 NEW WORK PLANS & INTERIOR ELEVATIONS

A-106 EXISTING CONDITIONS PHOTOS

ELECTRICAL DRAWINGS

E-001 ELECTRICAL COVER SHEET **ED-101 LIGHTING DEMOLITION PLAN** ED-102 ELECTRICAL DEMOLITION PLAN

E-200 AUDIO-VISUAL COVER SHEET

E-202 AUDIO-VISUAL NEW WORK PLAN

ENVIRONMENTAL DRAWINGS

HA1.01 HAZARDOUS MATERIALS ABATEMENT PLAN

All Contractors shall examine all drawings indicated herein for required coordination

A-103 ENLARGED PLANS & DETAILS **ENLARGED INTERIOR ELEVATIONS & DETAILS**

E-101 LIGHTING NEW WORK PLAN E-102 ELECTRICAL & LIGHTING NEW WORK PLAN

E-103 NOT USED

E-104 THEATRICAL LIGHTING CONTROLS E-105 ELECTRICAL SCHEDULES & DETAILS

E-201 AUDIO-VISUAL NEW WORK PLAN

CONSTRUCTION NOTES:

SCOPE OF WORK:

Contractor(s) shall comply with the current NEW JERSEY UNIFORM CONSTRUCTION CODE (UCC) REHABILITATION SUBCODE & all applicable subcodes, ordinances & regulations of federal, state, municipal, & other governing bodies

Contractor(s) shall be solely responsible for & have control over construction means, methods, techniques, sequences & procedures, shoring & bracing, jobsite safety, & for coordinating all portions of work. Prior to submitting a bid, the Contractor(s) shall visit the site of the Work & shall thoroughly familiarize themselves w/ the exist'g conditions affecting the work & shall report any errors to the Arch't. By the act of submitting a bid, the Contractor(s) shall be deemed to have made such an examination, to have accepted such conditions, and to have made allowance therefore in preparing their bid. No additional compensation will be granted on the account of extra work made necessary by the Contractors' failure to investigate such exist'g conditions. Contractor(s) shall perform the Work in accordance with the documents or assume responsibility for corrections.

Contractor shall keep the premises & surrounding area free from accumulation of waste mat'ls & rubbish caused by operations under the Contract. At completion of the Work the Contractor shall remove from & about the Project waste mat'ls, rubbish, the Contractor's tools, construction equipment, machinery, &

General Contractor shall be responsible for all temporary utilities restroom facilities.

General Contractor shall be responsible for providing all necessary permits. Complete building permit application and file with authorities having jurisdiction within five days of the Notice

to Proceed or the date of execution of the Contract, whichever is later. Fees shall be paid for by the Owner or reimbursed after submission of receipt to Architect for Owner's

DIMENSIONS: Are to outside surface of finish mat'ls unless shown otherwise.

All dimensions are nominal and shall be field verified.

Contractor shall unconditionally warranty their work to be free of defects in materials and workmanship for a

period of two (2) years from the date of Substantial Completion. Products shall carry a Manufacturer's warranty for a minimum of two (2) years from the date of Substantial Completion or as indicated in the Manufacturer's warranty documentation provided w/ the product;

Any defects found w/in the warranty period shall be repaired or replaced w/o additional cost to the Owner.

Prior to commencement of the Work, the Contractor shall survey the exist'g conditions & record them by use of preconstruction photographs &/or videotapes (or as per Section 013233 - Photographic Documentation

of the Project Manual). Provide Architect with an electronic copy of the survey. Prior to the commencement of the Work, the Contractor shall verify through the Owner's fire alarm vendor, (Add vendor contact info or indicated in Section 024119 Selective Demolition of the Project Manual) the status of the entire exist'g fire alarm system & submit a written report indicating the status of the system &

list all devices that are inoperative. Otherwise, the Contractor takes full responsibility for all non-Do not proceed w/ any interruption of services w/o Owner's written permission. Doors, frames & hardware shall not be removed until replacements have been delivered to the Project Site. Prior to the commencement of the Work, the Contractor shall review with the Owner all mat'ls & equipment

to be removed. Should the Owner opt to keep any items, the Contractor shall salvage & deliver the items

to the Owner on the site where so directed & properly dispose of all other demolition & construction Remove all interior walls, flooring & clg finishes, fixtures & other items as noted on dwgs. Protect existing flooring to remain during the construction period with covering of hardboard panels or other suitable material. Do not use paper or plastic sheeting. Do not move heavy and sharp objects directly over exist'g or proposed flooring. Protect flooring as indicated above to prevent damage from storing or

moving objects over flooring. Refer to Electrical documents for additional requirements.

REPAIR, PATCH & PAINT: All areas disturbed during demolition & construction shall match adjacent mat'ls & finishes at project

Exist'g openings in clgs & walls shall be patched to match adjacent mat'ls & finishes.

Scrape, clean & patch exist'g concrete floor to provide an acceptable level floor. Prepare surface to receive specified floor finish.

Contractor is responsible for preparing, finishing and all required testing of the concrete slabs in accordance with the most stringent requirements of the finish floor systems specified and selected by the Owner.

Scrape, shot blast, clean & patch as per ASTM D4259, Standard Practice for Abrading Concrete to expose bare concrete & provide an acceptable level floor. Prepare surface to receive specified floor finish. Contractor shall ensure that the existing concrete work complies with the requirements of the finish floor manufacturer(s) selected for use on this project. This includes, but is not limited to, tolerances and conditions, rapid relative humidity testing as per ASTM F2170, Standard Test Method for Determining Relative Humidity in Concrete Floor Slabs Using in situ Probes, bond testing, and alkalinity testing. General Contractor shall supply the Architect with copies of all test results, the finish floor manufacturer's

concrete subfloor requirements, and letters of acceptance from the finish floor manufacturer(s) prior to proceeding with the concrete subfloor work. The use of curing compounds on subfloors where finish floor manufacturers prohibit their use shall not be

Where cement based interior self-level'g underlayment is req'd, it shall be the responsibility of the Contractor to provide an underlayment compatible with the specified finish floor. Where new concrete is req'd, it shall be the responsibility of the Contractor to review the intended concrete design mix with the limitations imposed by the finish floor manufacturers, and if necessary, make recommendations to the Architect of an amended design mix that would better facilitate the standards of

the finish floor manufacturer's requirements. No additional compensation shall be awarded for the use of an alternative design mix. The use of curing compounds on subfloors where finish floor manufacturers prohibit their use shall not be

Contractor shall be required to employ whatever means necessary to meet the requirements of the finish

floor manufacturers for concrete slabs without additional compensation or time extension. Minimum Uniformly Distributed (PSF) & Concentrated (LBS) Live Loads - (IBC – NJ 2021 Tables 1607.1)

Assembly areas, Fixed seats (fastened to floor) 150 PSF Assembly areas, Stage floors 100 PSF Assembly areas, Platforms Assembly areas, Follow spot, projections and control rooms___ 40 PSF, 300 LBS

Catwalks for maintenance and service access **INTERIOR WALLS:** Follow drawings for interior wall types.

Diagonally brace load-bearing interior walls.

Door handles, pulls, latches, locks & other operating devices max 48" AFF.

Key as directed by Owner. **WORK SURFACÉS:**

Provide solid surface finish on all new work surfaces.

Heights & clearances shall accommodate provisions set forth in ANSI A117.1, 2017 edition & the ADA. Provide all required blocking & supports for all wall mounted items.

SUBCODES

THE FOLLOWING SUBCODES AS ADOPTED BY THE NEW JERSEY UNIFORM CONSTRUCTION CODE (N.IAC. 5:23 et seg.) SHALL APPLY TO THIS PROJECT

(NJAC 5:23 et seq.) SHALL AP	PLY TO THIS PROJECT.	
SUBCODE	NATIONAL MODEL CODE	UCC REFERENCE
BUILDING	INTERNATIONAL BUILDING CODE NJ ED/2021	NJAC 5:23-3.14
PLUMBING	NATIONAL PLUMBING CODE /2021	NJAC 5:23-3.15
ELECTRICAL	NATIONAL ELECTRICAL CODE /2020	NJAC 5:23-3.16
ENERGY	ASHRAE 90.1-2019	NJAC 5:23-3.18
MECHANICAL	INTERNATIONAL MECHANICAL CODE /2021	NJAC 5:23-3.20
FUEL GAS	INTERNATIONAL FUEL GAS CODE /2021	NJAC 5:23-3.22
REHABILITATION	REHABILITATION SUBCODE RENOVATION 6.5 AND ALTERATION 6.6	NJAC 5:23-6
BARRIER FREE	ICC/ANSI A117.1-2017	NJAC 5:23-7

REGAN YOUNG, AIA REGAN YOUNG ENGLAND BUTER*!* 456 HIGH STREET • MT. HOLLY, NEW JERSEY 08060 USA +1(609)265-2652/-0333FAX • 21AI00912100 • RYEBREAD.COM

PROJECT TITLE & ADDRESS:
AUDITORIUM RENOVA
EW HOLDEIN COHOOL

F.W. HOLBEIN SCHOOL BLOCK 41.05, LOT 12.09 333 LEVIS DRIVE **MOUNT HOLLY NEW JERSEY 08060**


OWNER ADDRESS:


MOUNT HOLLY TOWNSHIP BOE 333 LEVIS DRIVE **MOUNT HOLLY NEW JERSEY 08060**


5733A


REVISION DATE:	Addendum-01 9/26/23

١.		
	DRAWING DATE:	07 AUG 2023
	PRINT DATE:	9/26/23
	DRAWN BY:	PF
	SHEET TITLE:	COVER SHEET

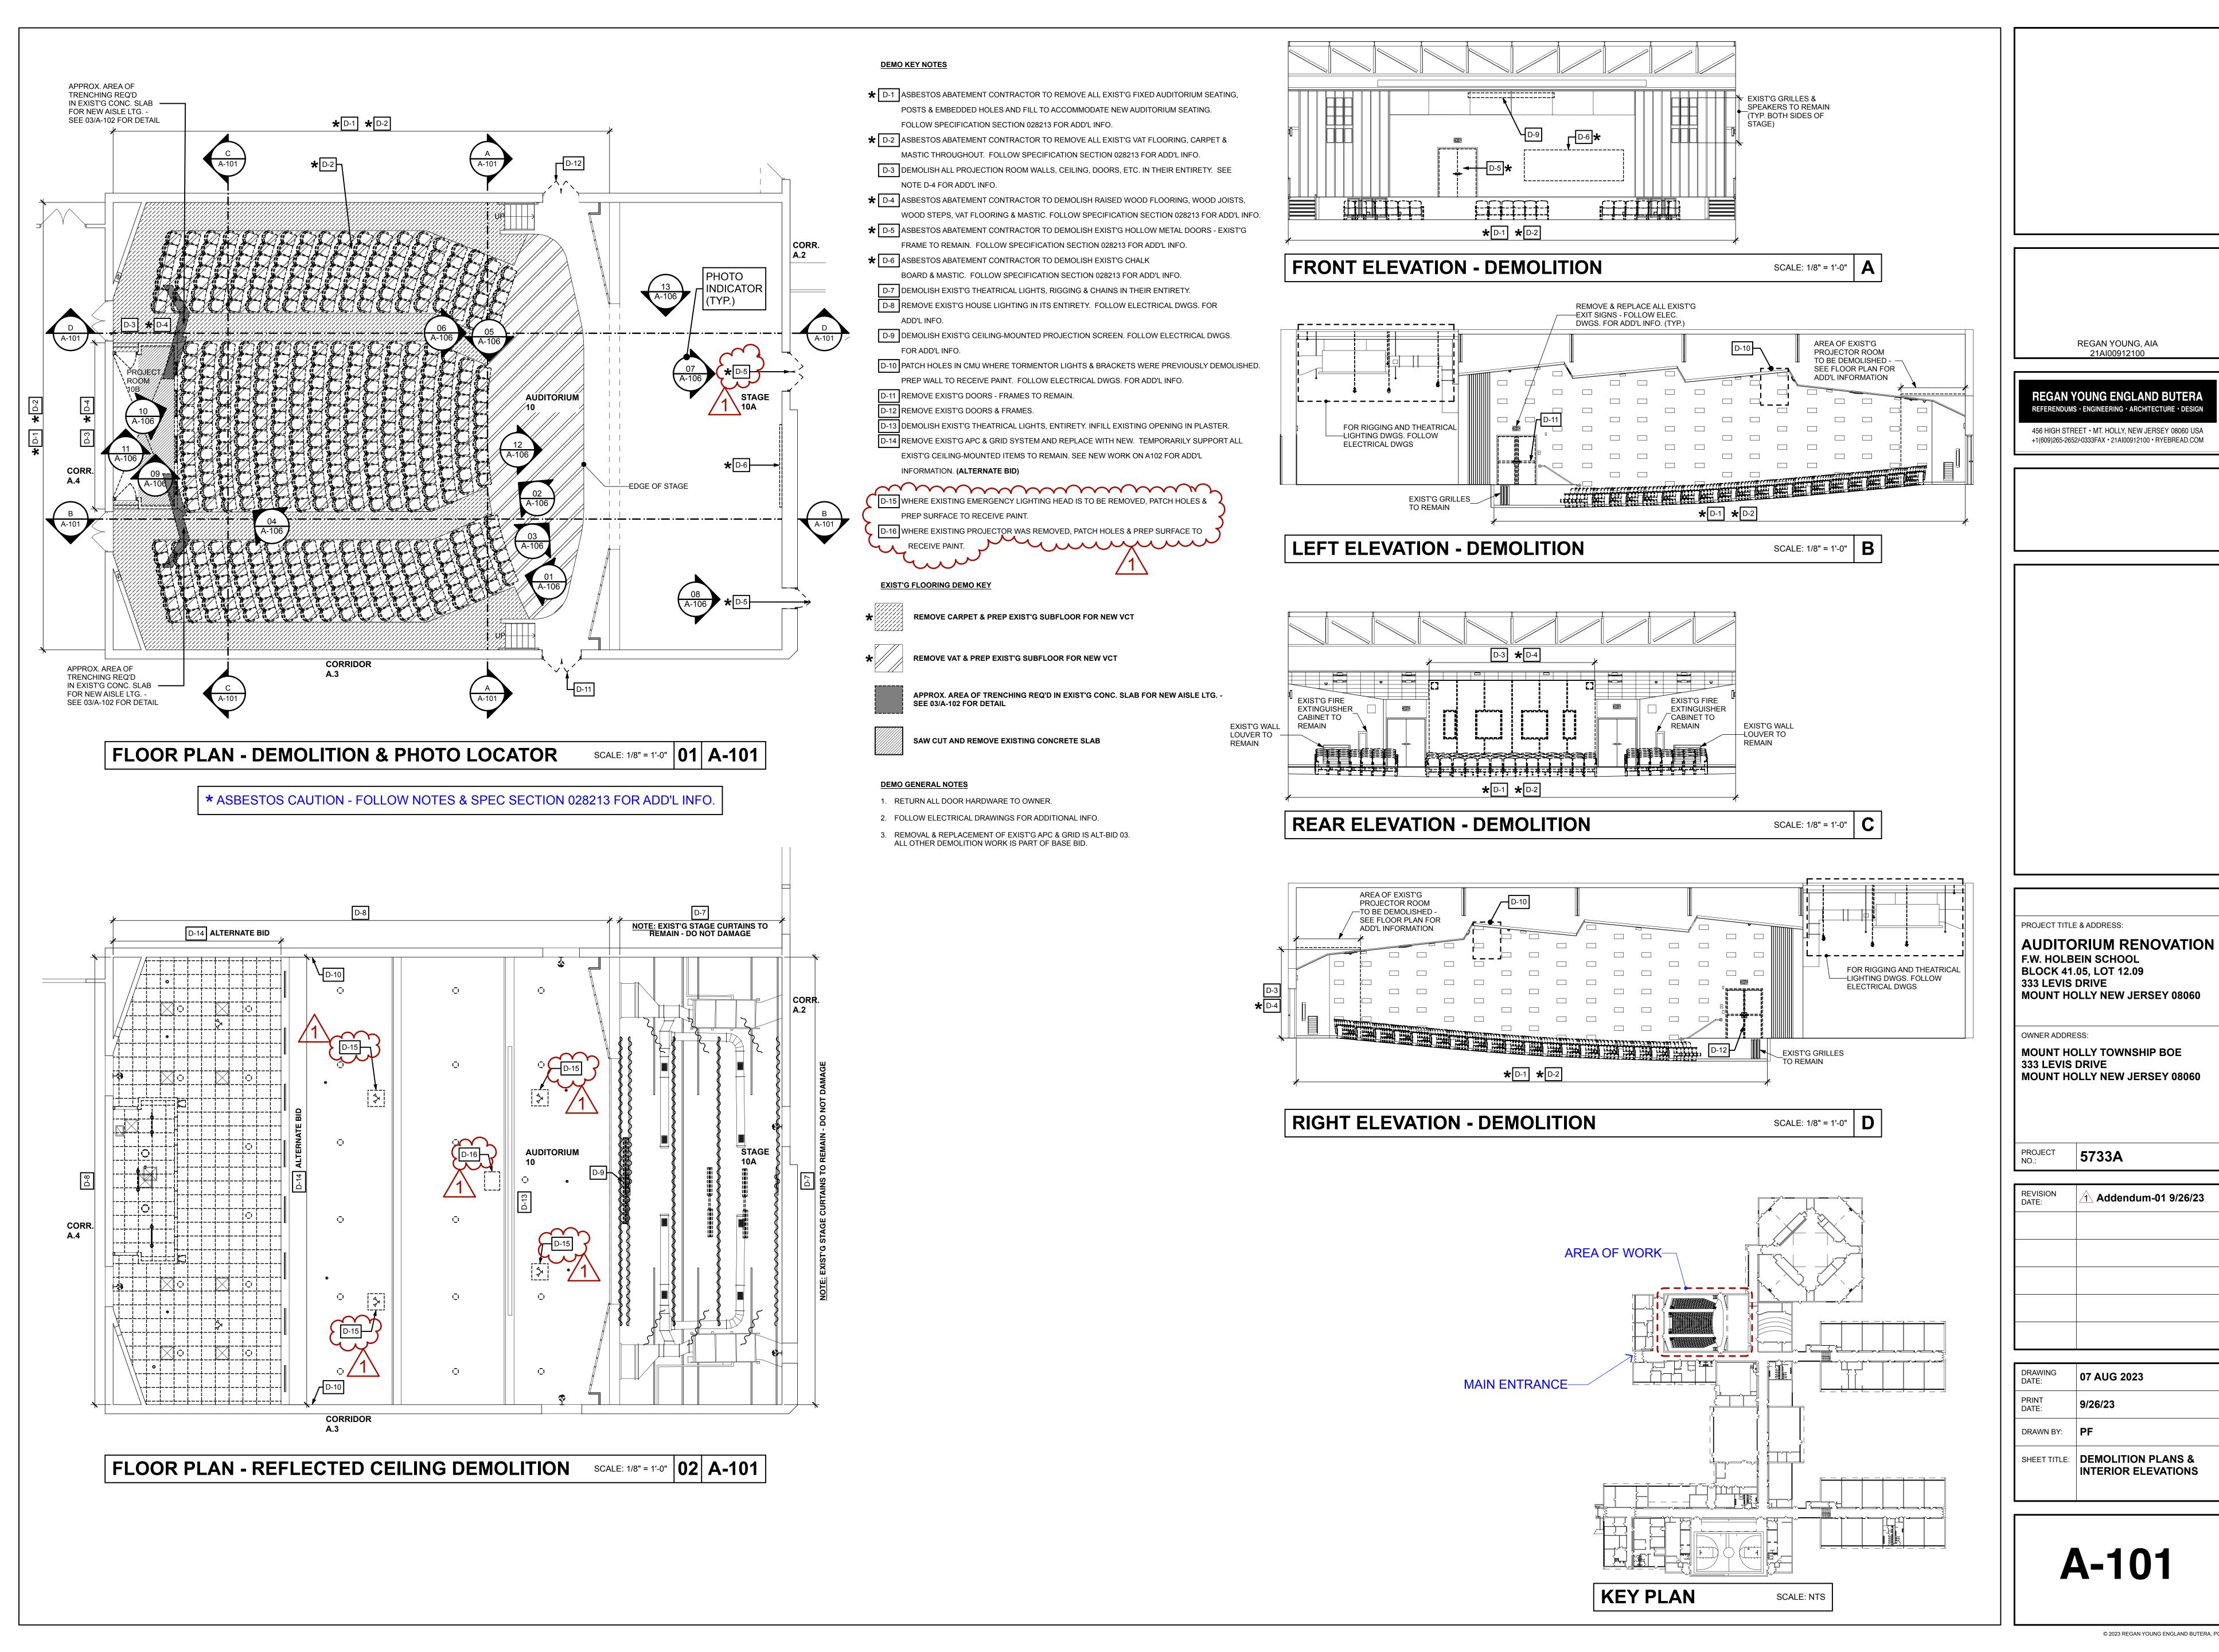


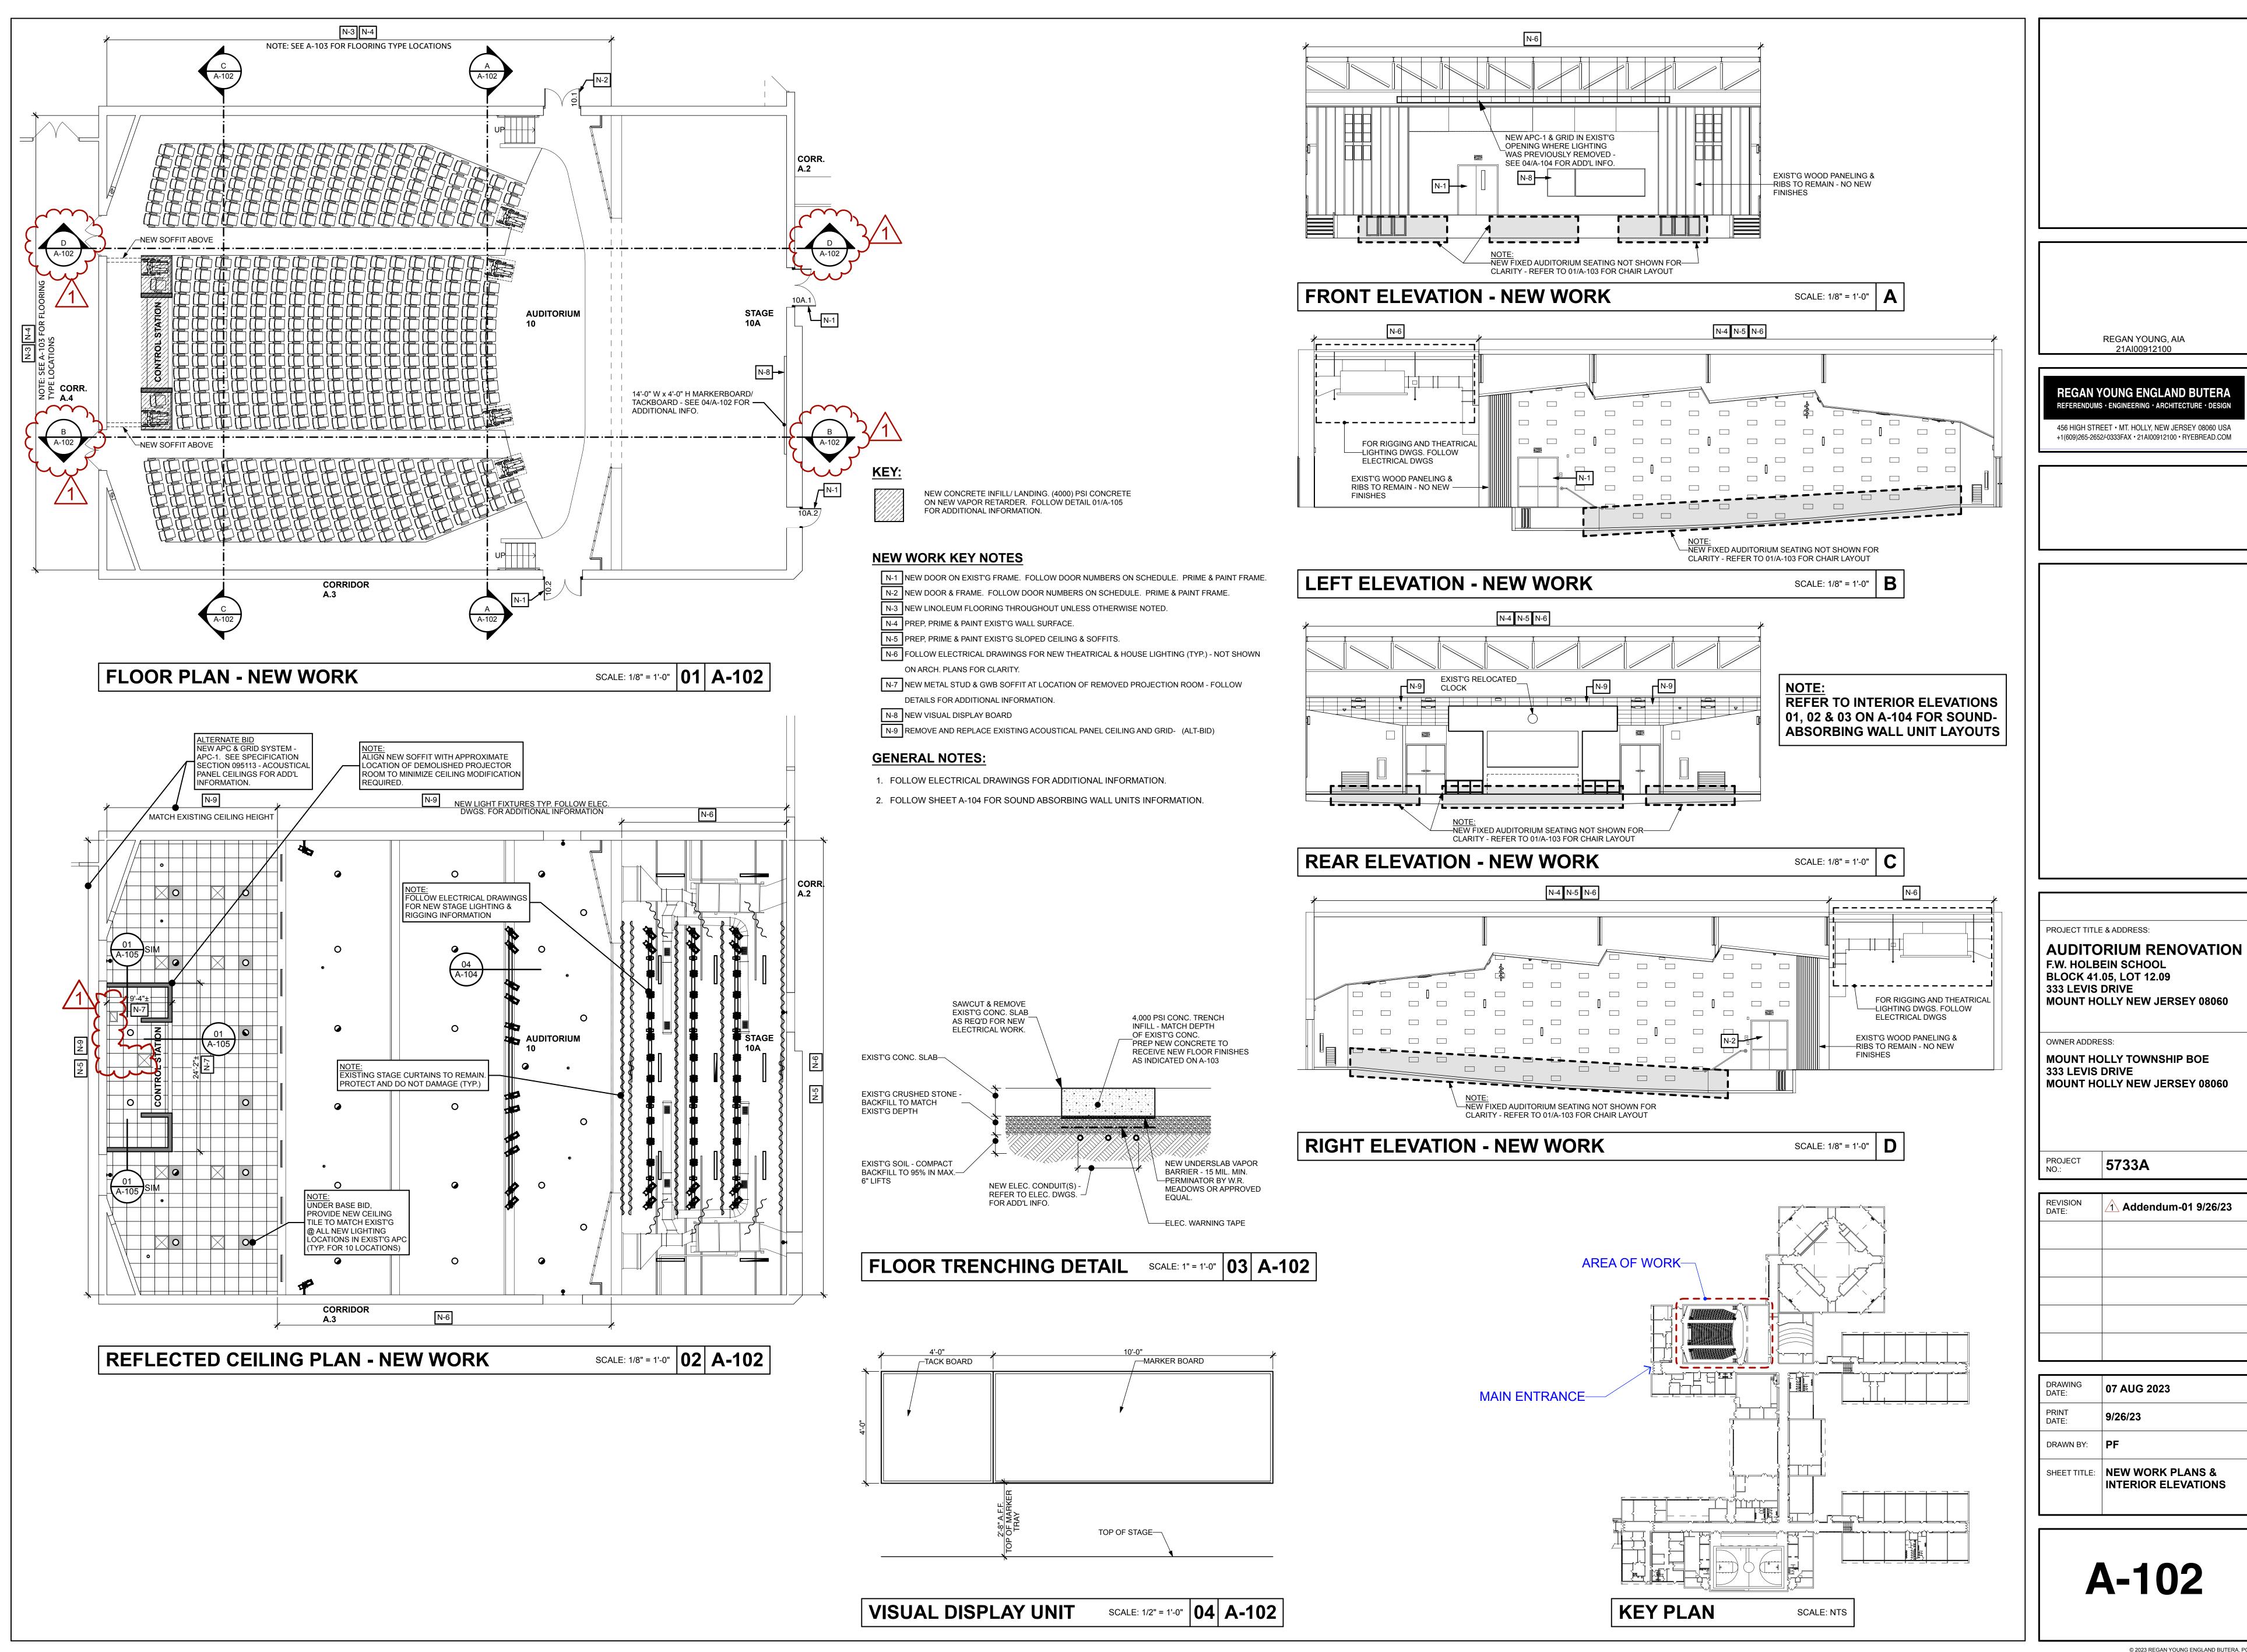

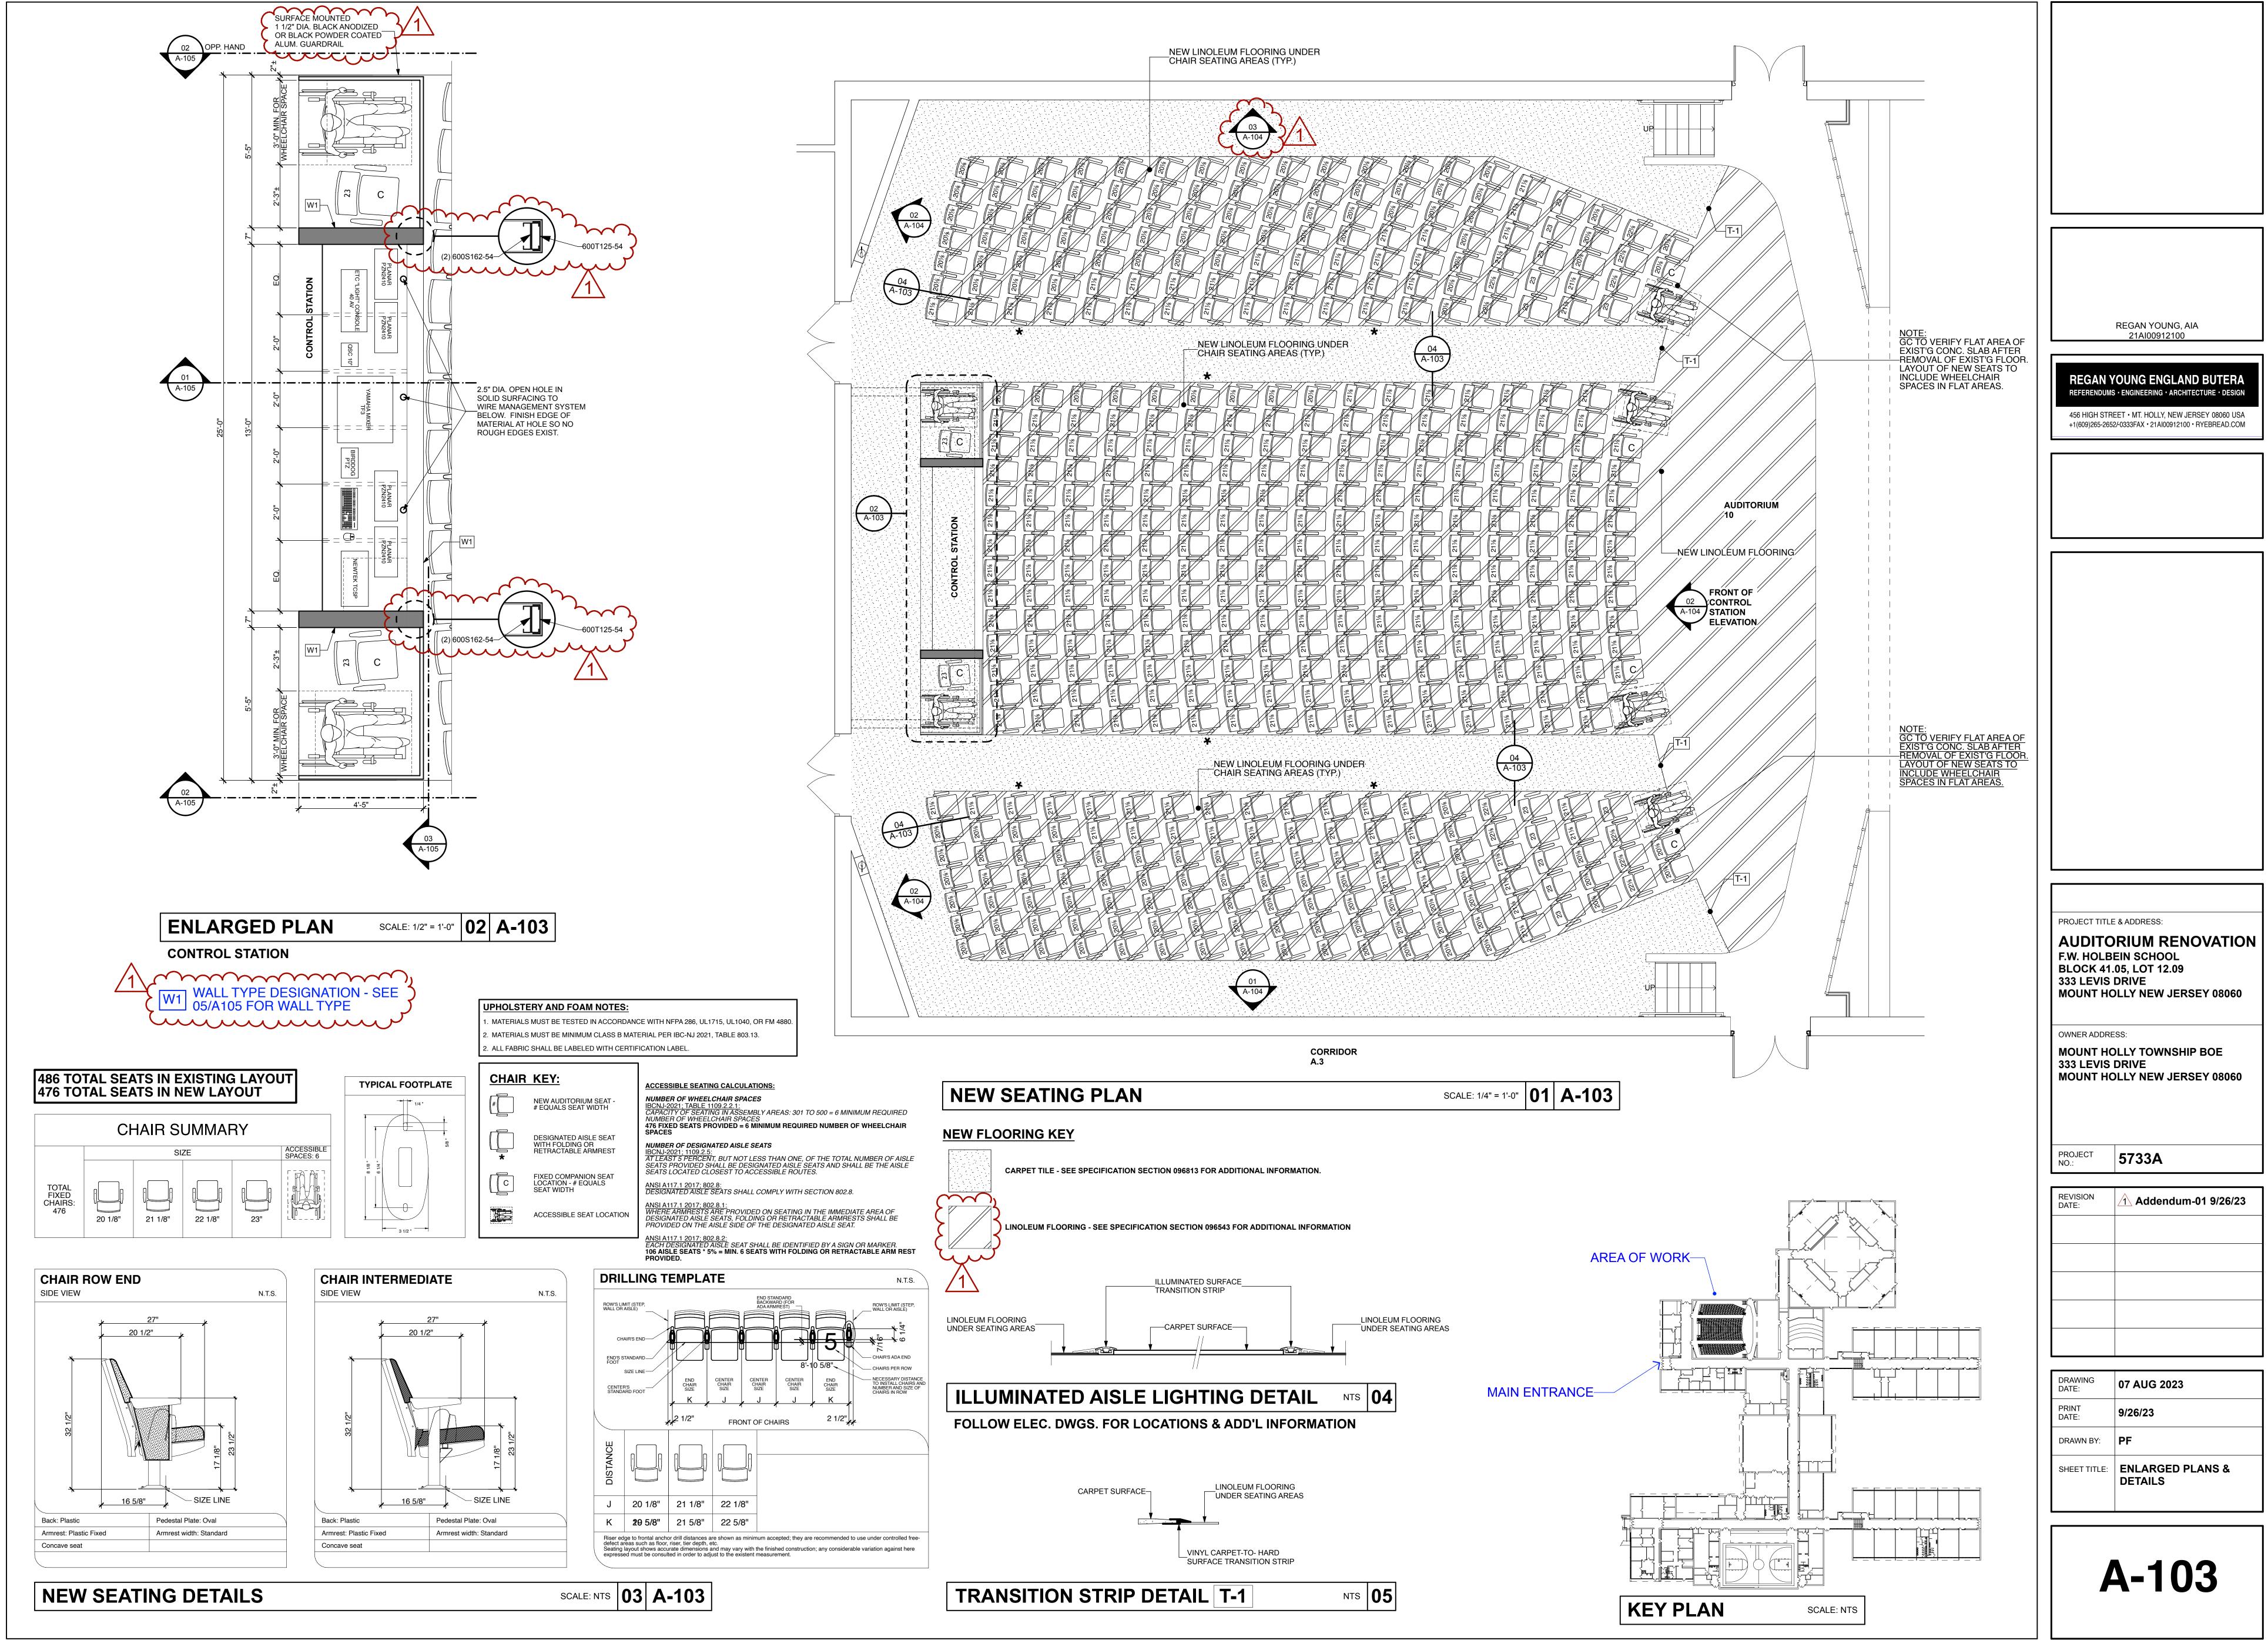


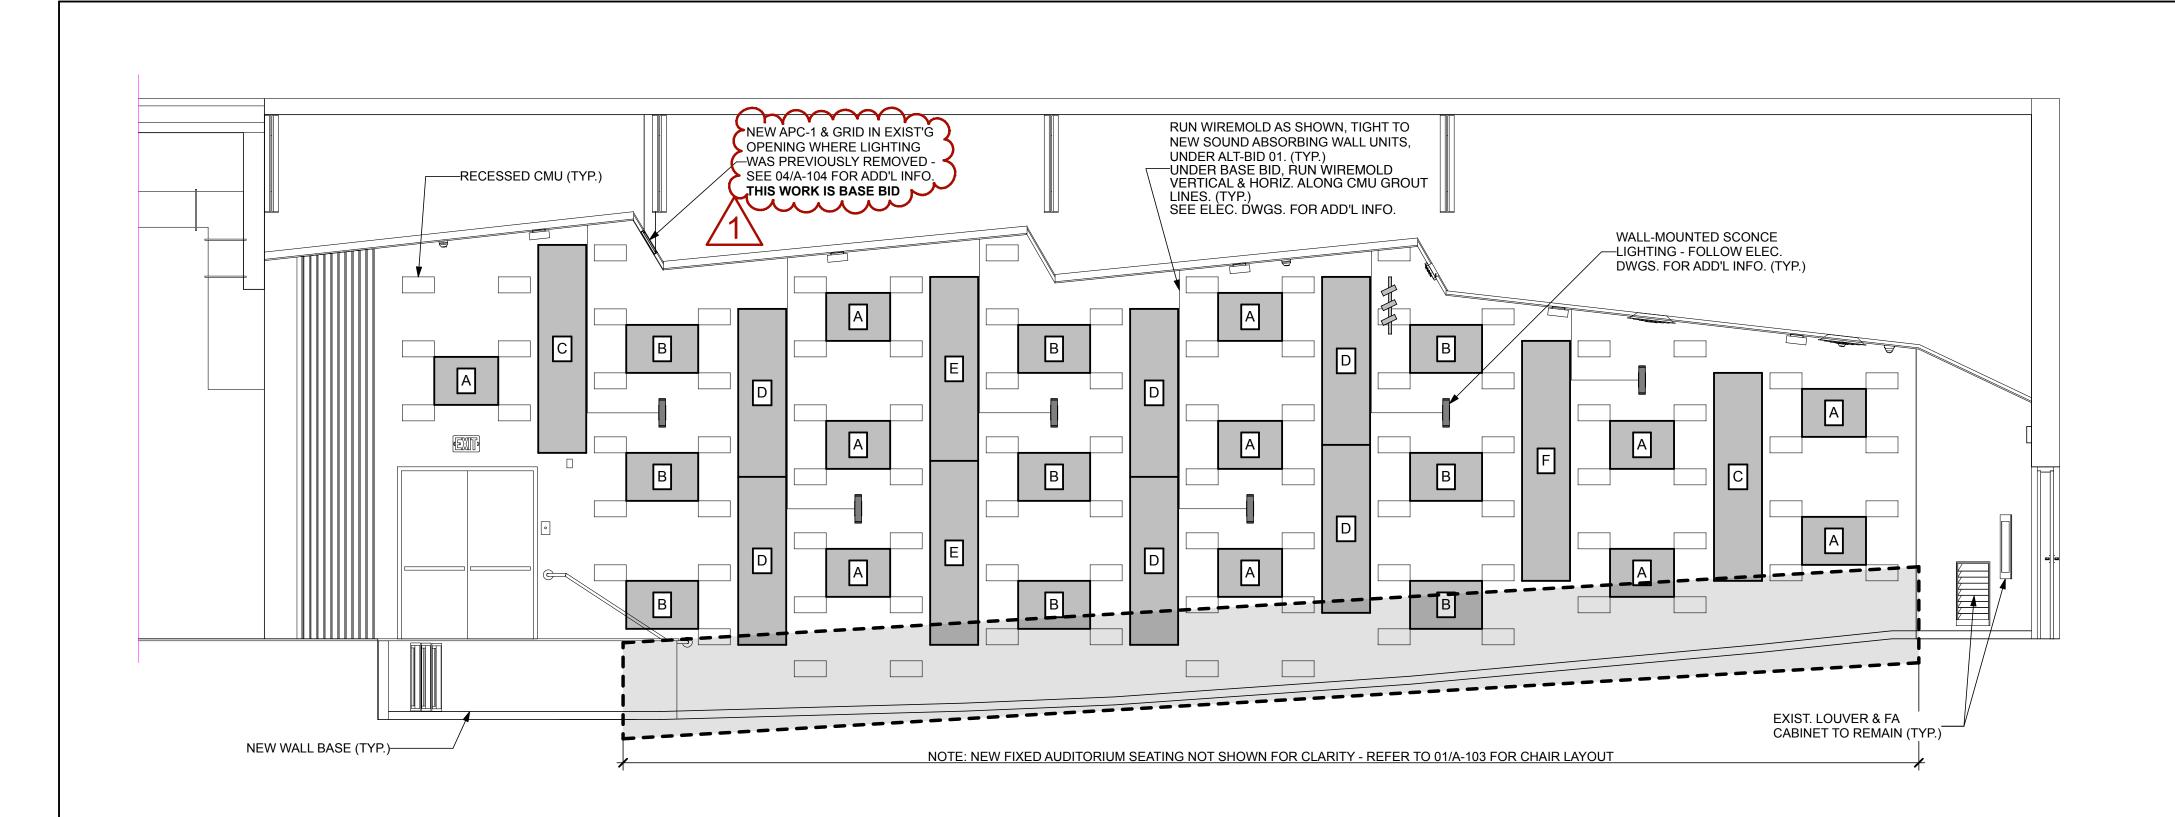


SOUND-ABSORBING WALL UNITS LAYOUT - ALT. BID SCALE: 1/4" = 1'-0" 01 A-104

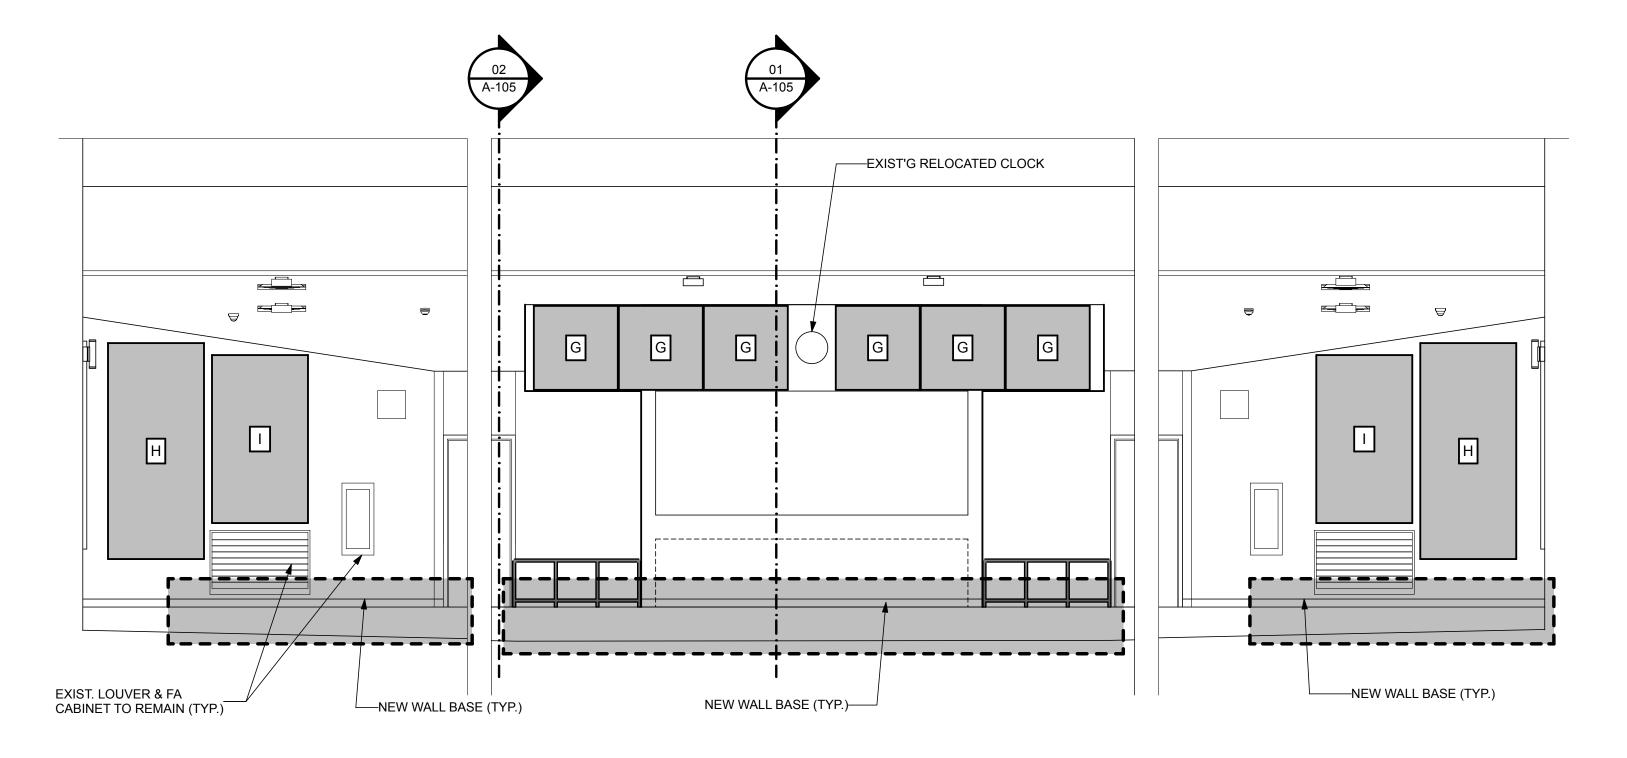


SOUND-ABSORBING WALL UNITS LAYOUT - ALT. BID SCALE: 1/4" = 1'-0" 02 A-104

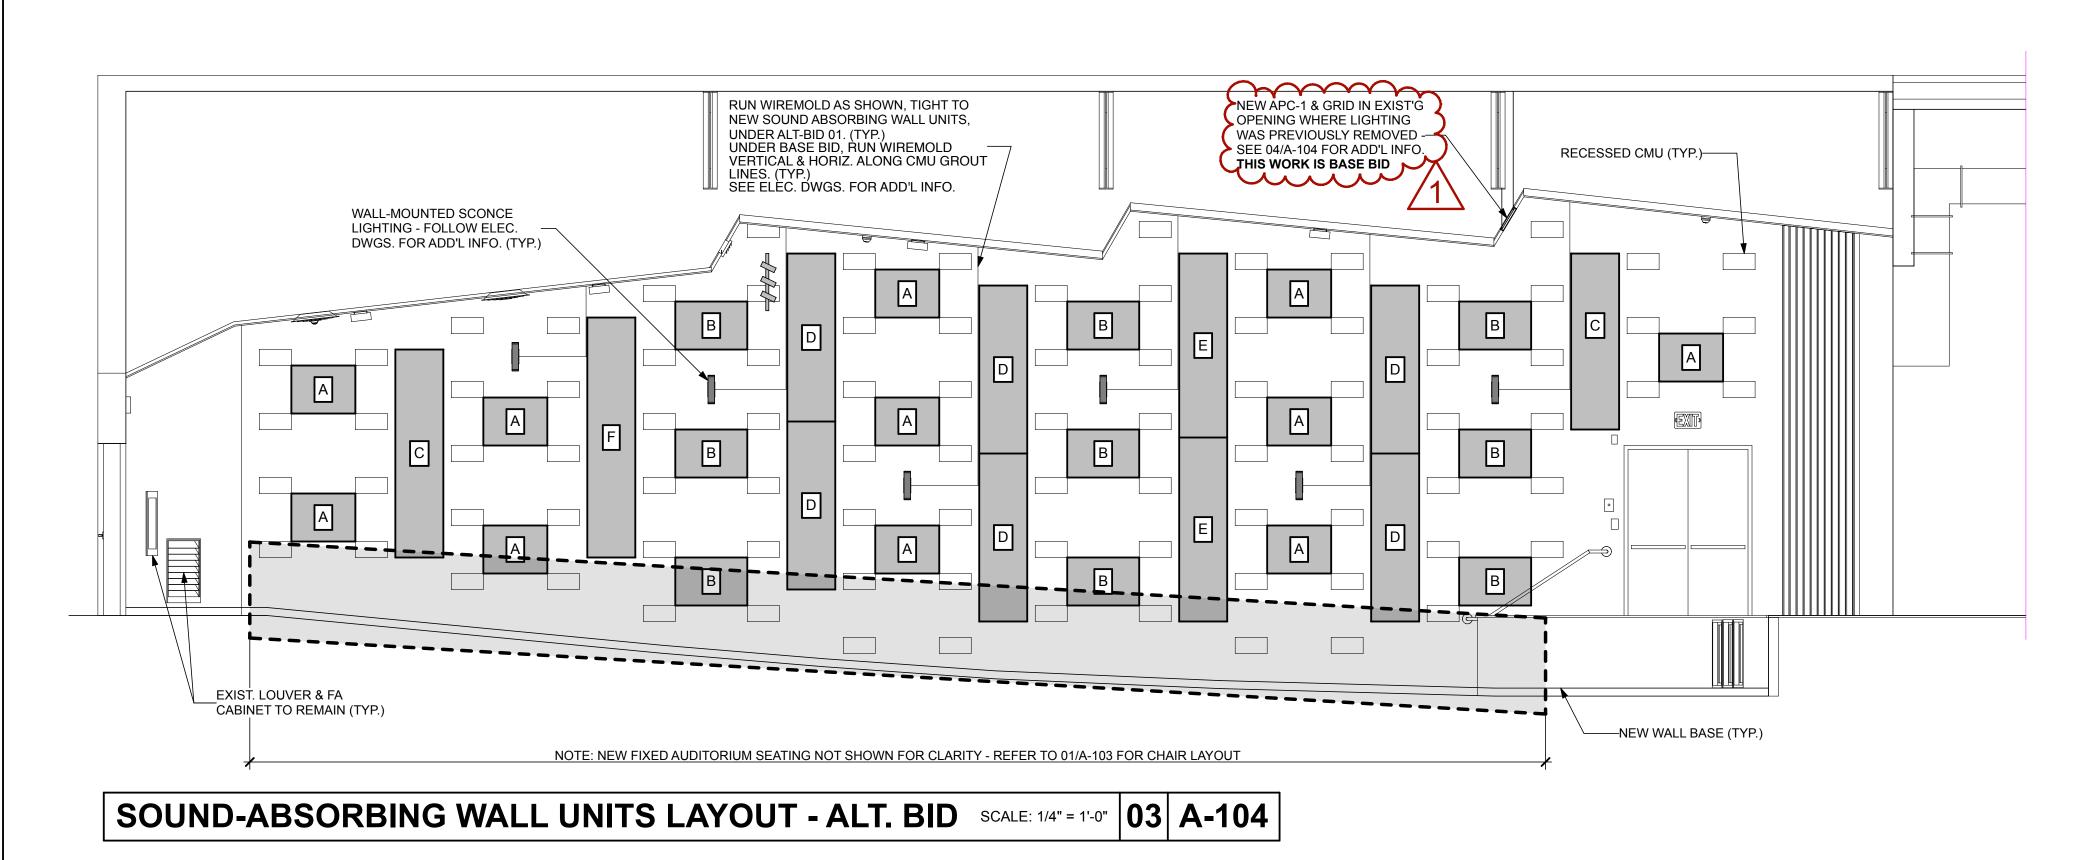

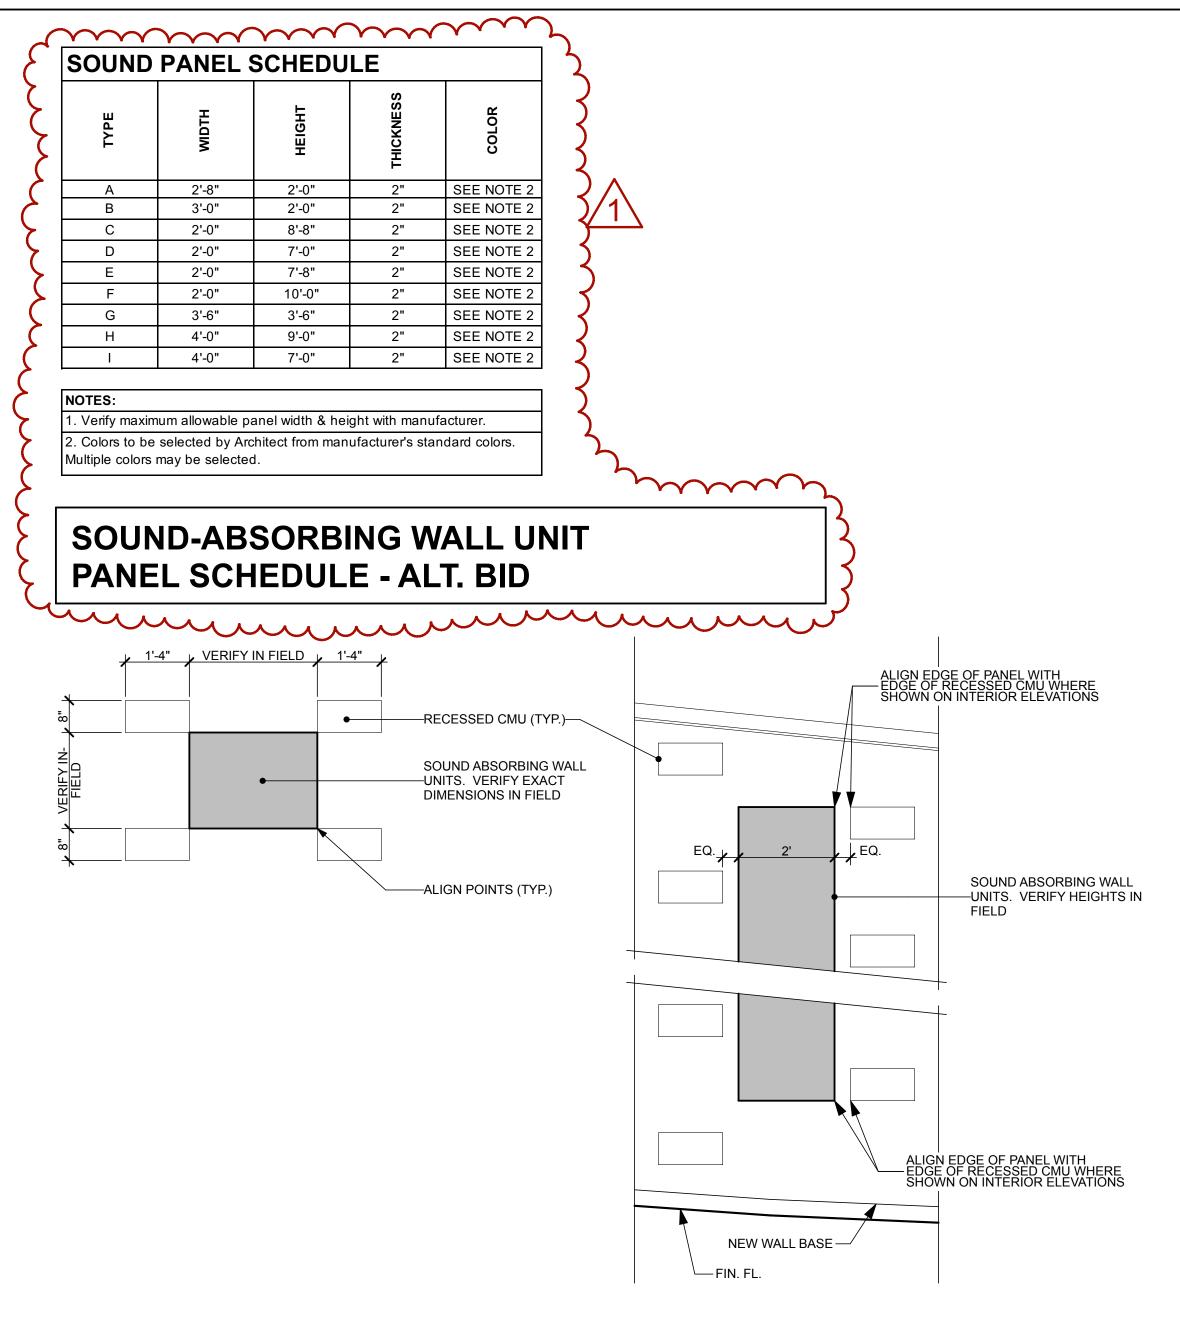


TYP. SOUND-ABSORBING WALL UNIT PANEL LOCATION- ALT. BID

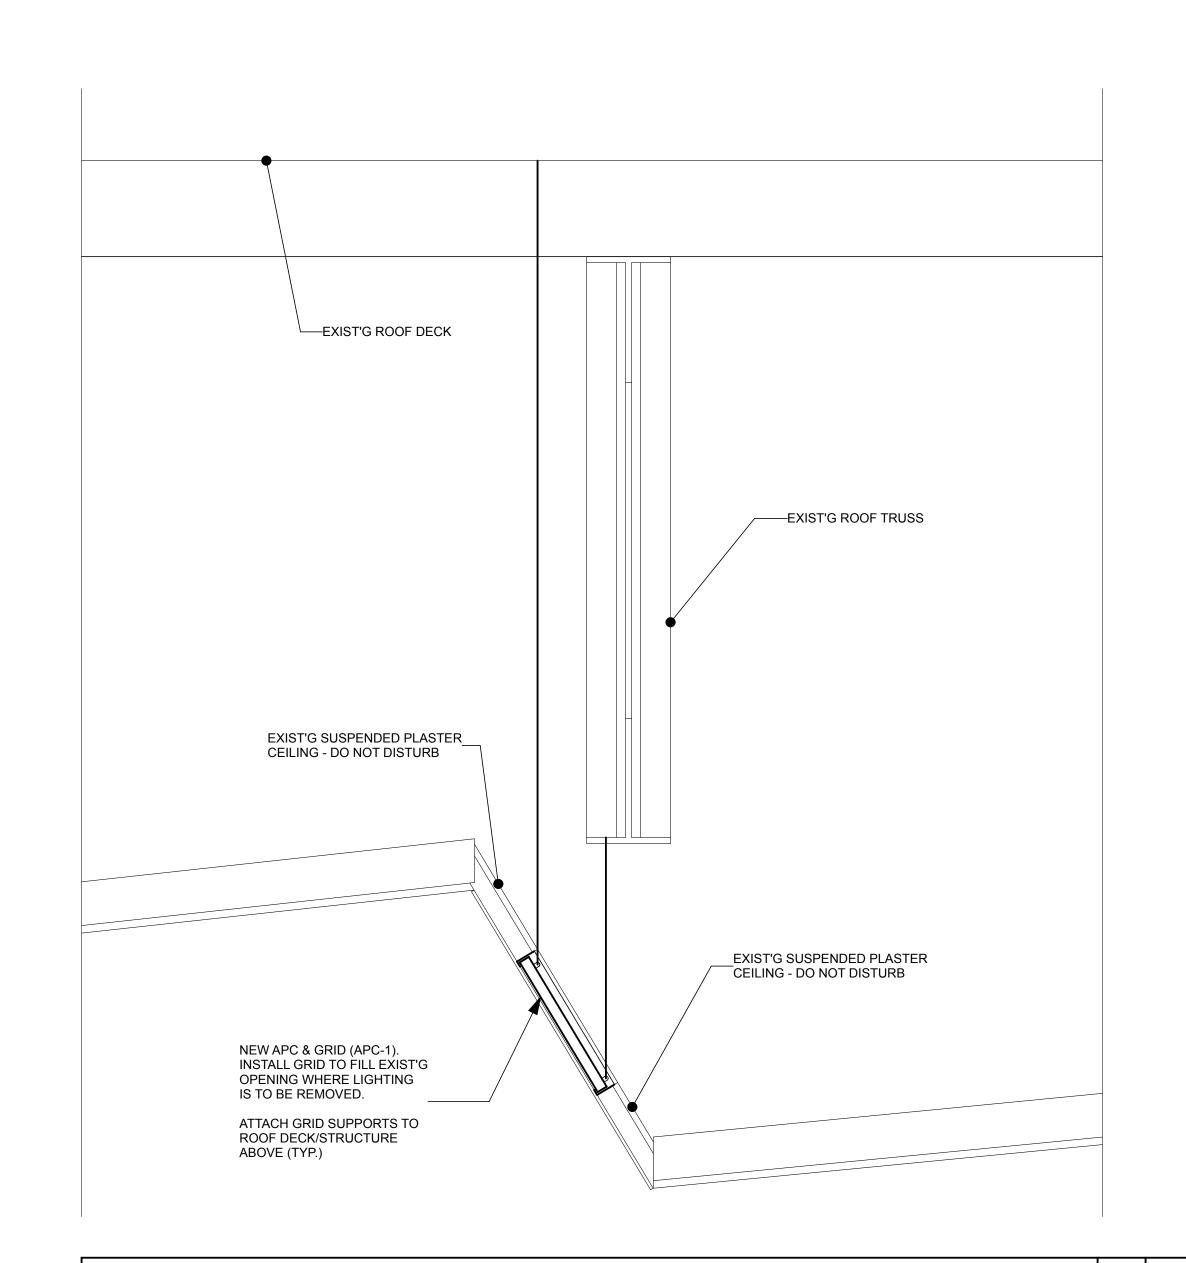

ANGLED CEILING OPENING INFILL DETAIL
BASE BID

SCALE: 1 1/2" = 1'-0" 04 A-104

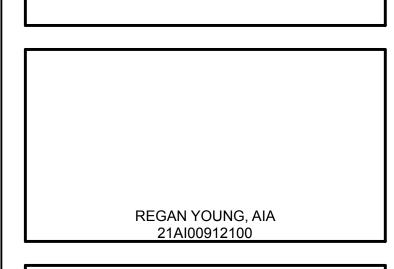

REGAN YOUNG ENGLAND BUTERA
REFERENDUMS • ENGINEERING • ARCHITECTURE • DESIGN

456 HIGH STREET • MT. HOLLY, NEW JERSEY 08060 USA
+1(609)265-2652/-0333FAX • 21AI00912100 • RYEBREAD.COM

PROJECT TITLE & ADDRESS:

AUDITORIUM RENOVATION
F.W. HOLBEIN SCHOOL
BLOCK 41.05, LOT 12.09

OWNER ADDRESS:

MOUNT HOLLY TOWNSHIP BOE
333 LEVIS DRIVE
MOUNT HOLLY NEW JERSEY 08060

MOUNT HOLLY NEW JERSEY 08060

PROJECT **5733A**

333 LEVIS DRIVE

REVISION Addendum-01 9/26/23


DRAWING DATE: 07 AUG 2023


PRINT DATE: 9/26/23

DRAWN BY: PF

SHEET TITLE: ENLARGED INTERIOR ELEVATIONS & DETAILS

A-104

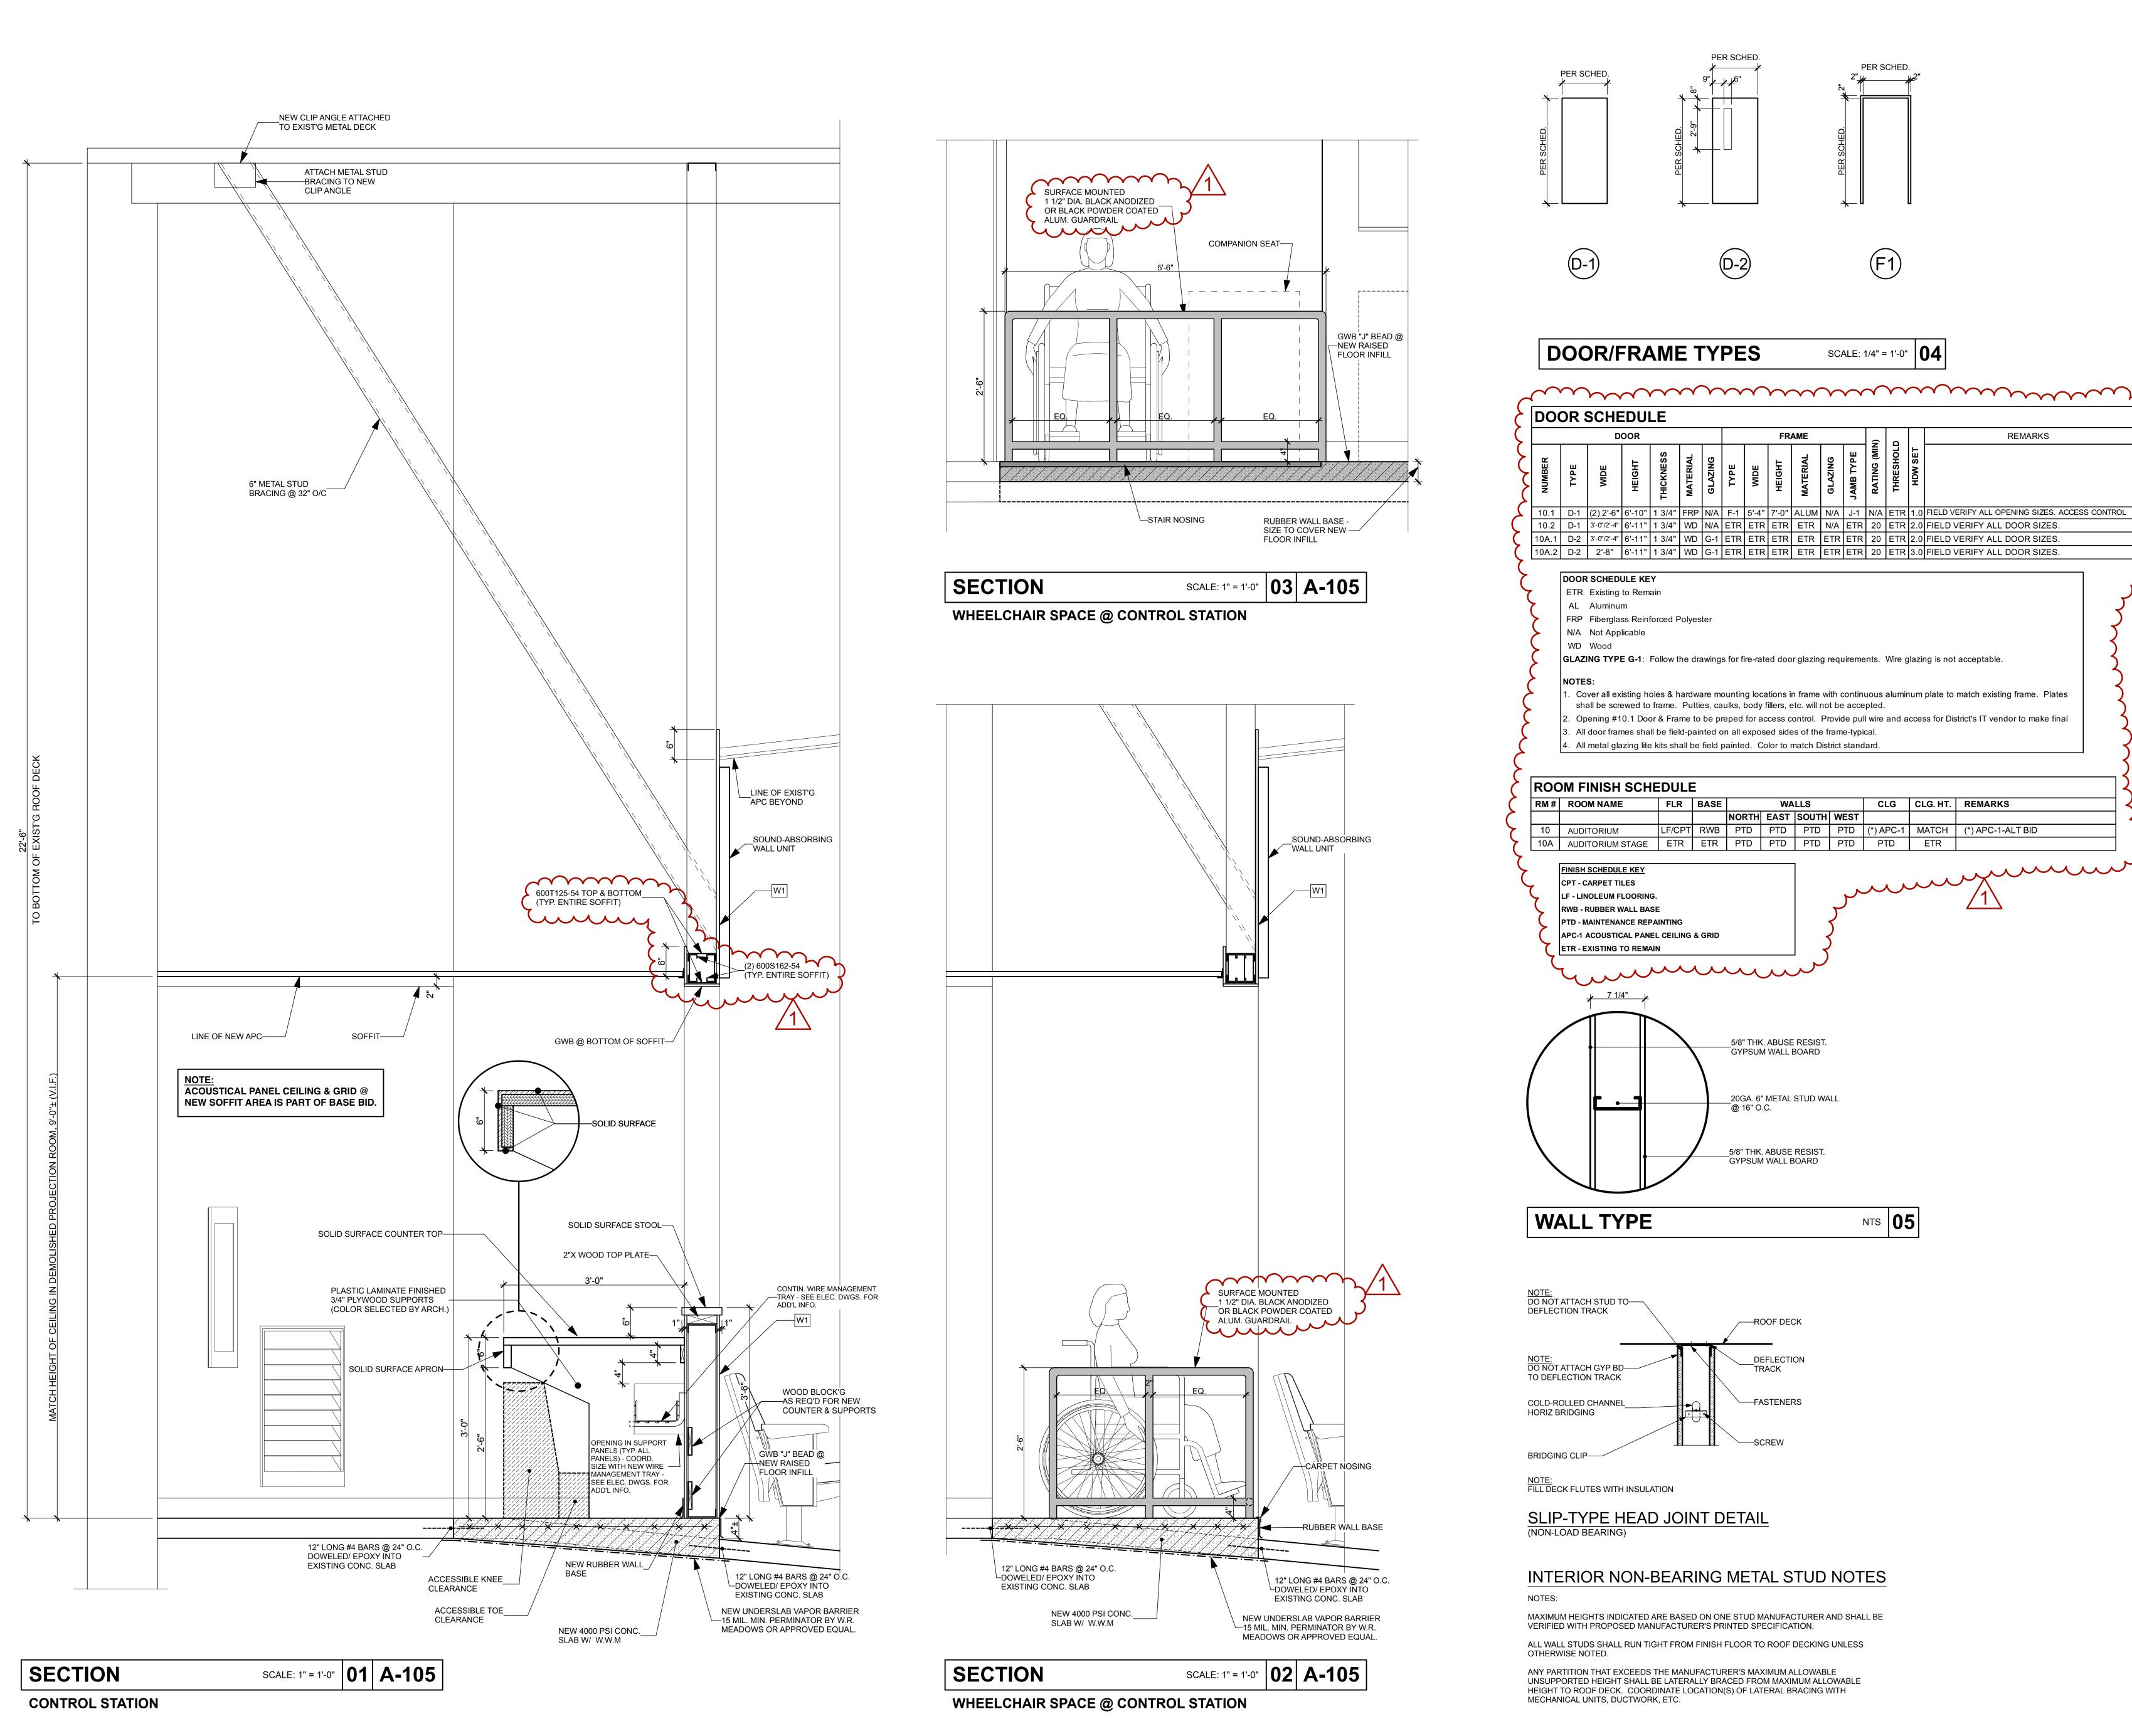

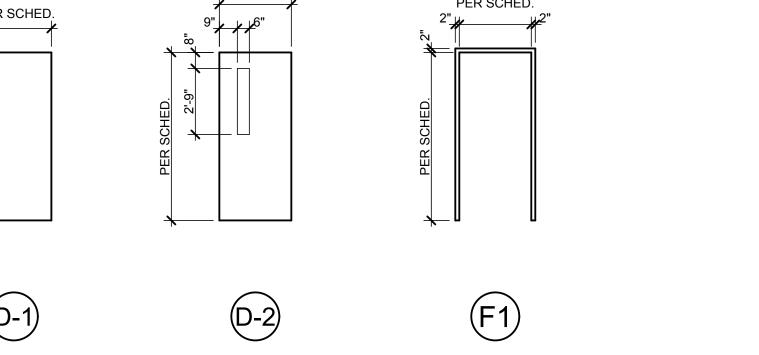

DOO	OR S	SCHE	DU	LE														
DOOR							FRAME						(1	D		REMARKS		
NUMBER	TYPE	WIDE	неіснт	THICKNESS	MATERIAL	GLAZING	TYPE	WIDE	неіснт	MATERIAL	GLAZING	JAMB TYPE	RATING (MIN)	THRESHOLE	HDW SET			
10.1	D-1	(2) 2'-6"	6'-10"	1 3/4"	FRP	N/A	F-1	5'-4"	7'-0"	ALUM	N/A	J-1	N/A	ETR	1.0	FIELD VERIFY ALL OPENING SIZES. ACCESS CONTROL		
10.2	D-1	3'-0"/2'-4"	6'-11"	1 3/4"	WD	N/A	ETR	ETR	ETR	ETR	N/A	ETR	20	ETR	2.0	FIELD VERIFY ALL DOOR SIZES.		
10A.1	D-2	3'-0"/2'-4"	6'-11"	1 3/4"	WD	G-1	ETR	ETR	ETR	ETR	ETR	ETR	20	ETR	2.0	FIELD VERIFY ALL DOOR SIZES.		
10A.2	D-2	2'-8"	6'-11"	1 3/4"	WD	G-1	ETR	ETR	ETR	ETR	ETR	ETR	20	ETR	3.0	FIELD VERIFY ALL DOOR SIZES.		

Opening #10.1 Door & Frame to be preped for access control. Provide pull wire and access for District's IT vendor to make final

	IZIVI #	NOOM NAME	I LIX	ב כ		***	LLO		0	0.11	KLMAKKO	
,					NORTH	EAST	SOUTH	WEST				
•	10	AUDITORIUM	LF/CPT	RWB	PTD	PTD	PTD	PTD	(*) APC-1	MATCH	(*) APC-1-ALT BID	
>	10A	AUDITORIUM STAGE	ETR	ETR	PTD	PTD	PTD	PTD	PTD	ETR		

REGAN YOUNG, AIA 21AI00912100

REGAN YOUNG ENGLAND BUTERA REFERENDUMS · ENGINEERING · ARCHITECTURE · DESIGN

456 HIGH STREET • MT. HOLLY, NEW JERSEY 08060 USA +1(609)265-2652/-0333FAX • 21AI00912100 • RYEBREAD.COM

PROJECT TITLE & ADDRESS:

AUDITORIUM RENOVATION F.W. HOLBEIN SCHOOL BLOCK 41.05, LOT 12.09 333 LEVIS DRIVE MOUNT HOLLY NEW JERSEY 08060

OWNER ADDRESS:


MOUNT HOLLY TOWNSHIP BOE 333 LEVIS DRIVE MOUNT HOLLY NEW JERSEY 08060

PROJECT 5733A

REVISION **1** Addendum-01 9/26/23

DRAWING 07 AUG 2023 PRINT 9/26/23 DATE: DRAWN BY: SHEET TITLE: DETAILS

A-105

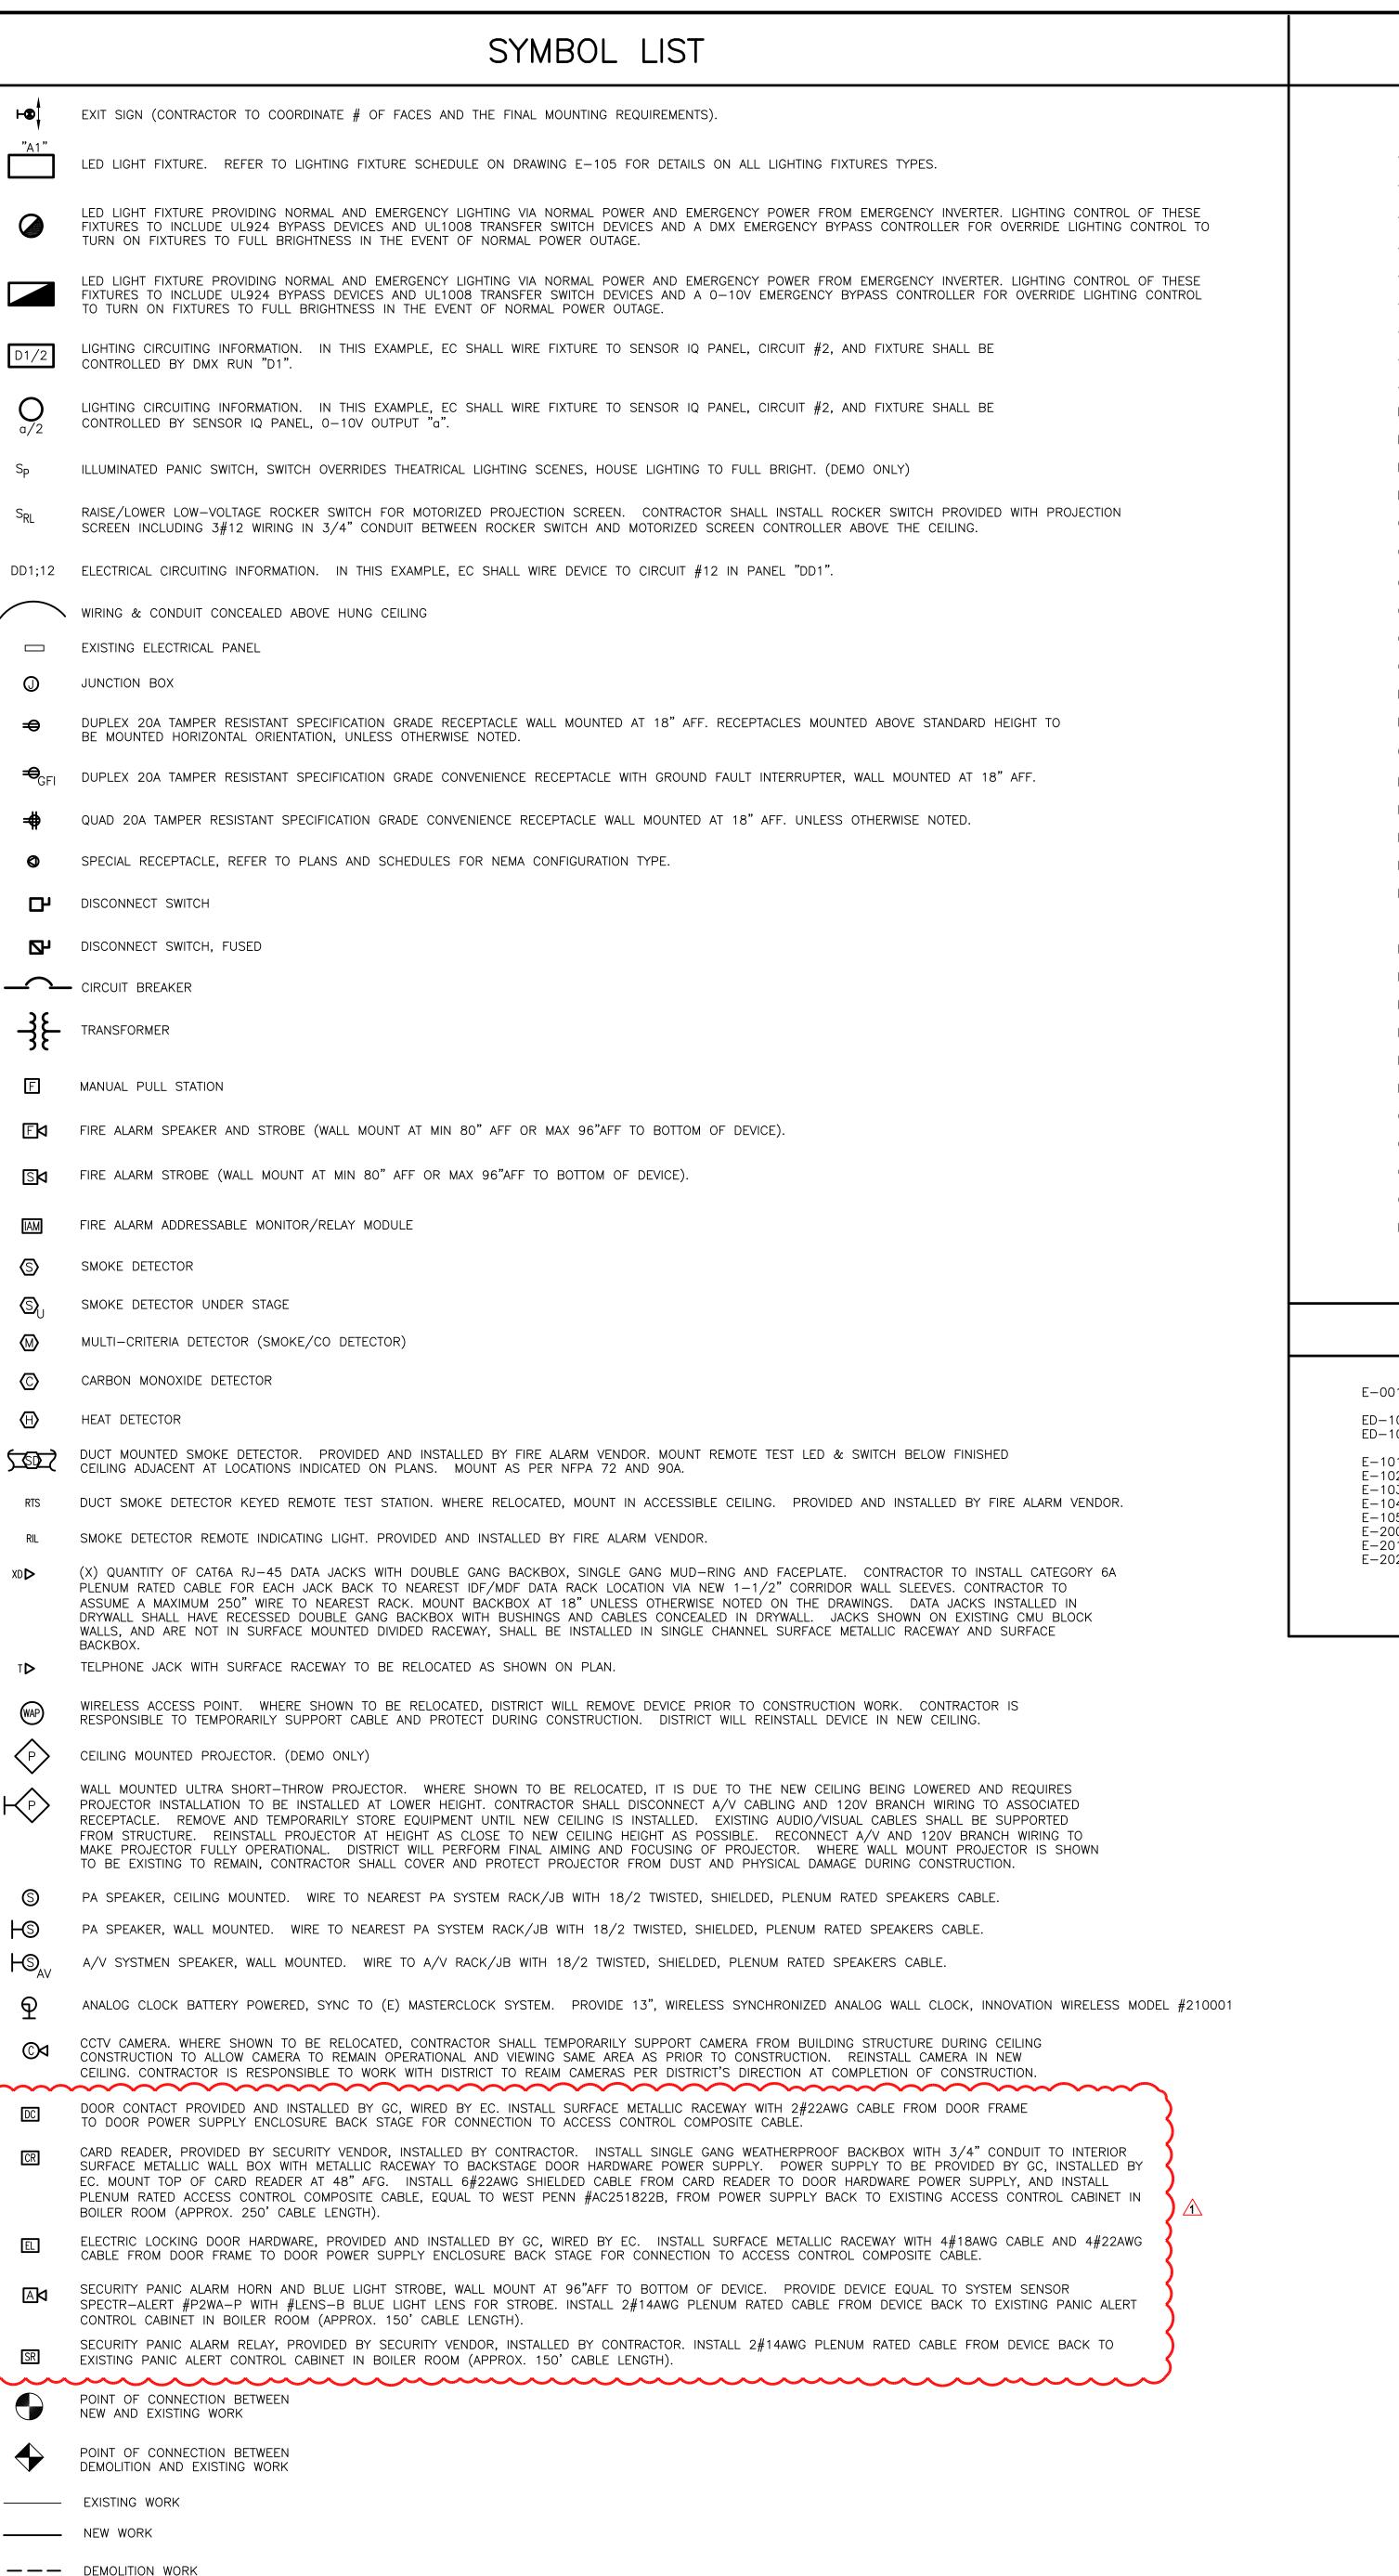

2

AMPERE HWH HOT WATER HEATER AUDIO/VISUAL IDF INTERMEDIATE DISTRIBUTION AIR CONDITIONING FRAME AMP FRAME ABOVE FINISHED CEILING ABOVE FINISHED FLOOR KEC KITCHEN EQUIPMENT

ABBREVIATIONS

AFF ABOVE FINISHED FLOOR

AFG ABOVE FINISHED GRADE

AT AMP TRIP

AUD AUDITORIUM

BFC BELOW FINISHED CEILING

BFF BELOW FINISHED FLOOR

KITCHEN EQUIPMENT

CONTRACTOR

KVA KILOVOLT AMPERE

KW KILOWATT

LLC WIRE TO LOCAL LIGHTING

CIRCUIT

AUD AUDITORIUM

BFC BELOW FINISHED CEILING

BFF BELOW FINISHED FLOOR

BOH BACK OF HOUSE

BTC BRANCH TO CIRCUIT

C CONDUIT

C/B CIRCUIT BREAKER

CKT CIRCUIT

KW KILOWATT

KILOWATT

KW KILOWATT

KILOWA

CKT CIRCUIT

CM CONSTRUCTION MANAGER

CR CONVENIENCE RECEPTACLE

CT CURRENT TRANSFORMER

DFA DOWN FROM ABOVE

DR DUPLEX RECEPTACLE

(E) EXISTING

MDP MAIN DISTRIBUTION

MH MANHOLE

MLO MAIN LUGS ONLY

(N) NEW

(N) NEW

EMERGENCY CIRCUIT

NIC NOT IN CONTRACT

EC ELECTRICAL CONTRACTOR

EM EMERGENCY

EOF ELECTRICAL OUT OF FLOOR

EOW ELECTRICAL OUT OF WALL

ERMS ENERGY REDUCTION

MAINTENANCE SWITCH

FA FIRE ALARM

OCC OCCUPANCY

OOF OUT OF FLOOR

OOW OUT OF WALL

PA PUBLIC ADDRESS

PC PLUMBING CONTRACTOR

(RAR) REMOVE AND REPLACE

(REL) RELOCATE/RELOCATED

FACP FIRE ALARM CONTROL PANEL

FLA FULL LOAD AMPS

FOH FRONT OF HOUSE

FPC FIRE PROTECTION CONTRACTOR

FU FUSE

GC GENERAL CONTRACTOR

GEL GROUND FAULT INTERRUPTER

SR SINGLE POLE SWITCH

SR SIMPLEX RECEPTACLE

THREE WAY SWITCH

SPD SURGE PROTECTIVE DEVICE

TYP TYPICAL

V VOLT

GROUND FAULT INTERRUPTER

V VOLT

W WATT

GENERAL PURPOSE

HORSEPOWER

WP WEATHERPROOF

GFCI GROUND FAULT CIRCUIT

LIST OF DRAWINGS

INTERRUPTER

E-001 ELECTRICAL COVER SHEET

ED-101 LIGHTING DEMOLITION PLAN
ED-102 ELECTRICAL DEMOLITION PLAN

E-101 LIGHTING NEW WORK PLAN
E-102 ELECTRICAL AND LIGHTING NEW WORK PLAN
E-103 NOT USED
E-104 THEATRICAL LIGHTING CONTROLS

E-104

E-105

ELECTRICAL SCHEDULES AND DETAILS

E-200

AUDIO-VISUAL COVER SHEET

E-201

AUDIO-VISUAL NEW WORK PLAN

E-202

AUDIO-VISUAL NEW WORK PLAN

GENERAL NOTES:

1. ALL DEVICE LOCATIONS ARE APPROXIMATE. FINAL LOCATIONS AND MOUNTING HEIGHTS SHALL BE FIELD LOCATED BY THE ENGINEER. THE CONTRACTOR SHALL INSTALL ALL DEVICES AT LOCATIONS AS DIRECTED BY THE ENGINEER WITHOUT ADDITIONAL COMPENSATION.

GENERAL NOTES

- 2. ALL BRANCH WIRING SHALL BE 2#12+1#12GND. MINIMUM CONDUIT SIZE SHALL BE 3/4".
- 3. ALL LIGHTING WIRING FOR LED DIMMABLE LIGHTING BRANCH CIRCUITS SHALL BE 2#12+1#12GND +2#16 0-10V IN 3/4"C (ALL 600V RATED WIRING) OR MC-PCS CABLE WHERE ALLOWABLE IN THE SPECIFICATION. FOR DMX WIRING PROVIDE 2#12 + 1#12GND + DMX CABLE (SEE DRAWING E1.3).
- 4. FOLLOW DIMENSIONS WHERE INDICATED, DO NOT SCALE DRAWINGS.
- 5. RECEPTACLES AND OTHER FLUSH MOUNTED DEVICES MOUNTED ON OPPOSITE SIDE OF SAME WALL MUST BE STAGGERED. USE OF BACK TO BACK BOXES IS NOT ACCEPTABLE.
- 6. ALL WIRING IN AREAS WITH EXISTING GYPSUM WALLS MUST BE FISHED THROUGH THE WALL WITH MC CABLE. WHERE EXISTING DEVICES WERE REMOVED, FILL IN MASONRY HOLES TO MATCH EXISTING WALL FINISH. UNLESS OTHERWISE INDICATED, WHERE CABLE IS NOT ABLE TO BE FISHED THRU THE WALLS, USE OF WIREMOLD, PAINT TO MATCH WALLS, IS ACCEPTABLE WITH APPROVAL OF ARCHITECT OR OWNER
- 7. ALL WORK SHALL BE IN ACCORDANCE WITH THE 2020 NATIONAL ELECTRICAL CODE AND OTHER APPLICABLE CODES AND STANDARDS.
- 8. ALL CONDUCTORS SHALL BE COPPER.
- 9. FIRE STOPPING: WHERE CONDUITS PENETRATE FIRE AND SMOKE BARRIERS INCLUDING WALLS, PARTITIONS, FLOORS, AND CEILINGS, INSTALL FIRE—STOPPING AT PENETRATIONS AFTER CABLES ARE INSTALLED.
- 10. MATERIALS FOR FIRE STOPPING SHALL BE UL LISTED AND LABELED AND FM APPROVED FOR FIRE RATINGS CONSISTENT WITH PENETRATED BARRIERS. SLEEVES SHALL BE SCHEDULE 40, WELDED, BLACK STEEL PIPE SLEEVES. SIZES AS REQUIRED FOR EQUIVALENT AREA AS THE WIREWAYS. SEALING FITTINGS SHALL BE SUITABLE FOR SEALING CABLES IN SLEEVES OR CORE DRILLED HOLES. TWO—PART SEALANT: FORMED—IN—PLACE SEALANT FIRE—RESISTANT JOINT SEALERS.
- 11. UNLESS OTHERWISE NOTED ALL INDOOR ELECTRICAL EQUIPMENT SHALL BE PROVIDED WITH, AND HOUSED IN, A NEMA 1 ENCLOSURE.
 ALL OUTDOOR ELECTRICAL EQUIPMENT SHALL BE INSTALLED IN NEMA 3R ENCLOSURE.
- 12. COMMON NEUTRALS ARE NOT ACCEPTABLE.
- 13. ELECTRICAL CONTRACTOR SHALL EXAMINE THE DRAWINGS OF ALL TRADES AND COORDINATE THEIR WORK TO AVOID INTERFERENCE WITH STRUCTURE, AND ALL EQUIPMENT ABOVE AND BELOW THE CEILING.
- 14. THE CONTRACTOR SHALL VERIFY ALL DIMENSIONS AND CONDITIONS AT THE SITE BEFORE PROCEEDING WITH THE WORK.
- 15. CONTRACTOR MUST COORDINATE ROOMS NAMES ON THE PANEL SCHEDULES WITH THE FINAL ROOM NAMES, IN THE FIELD.

18. ALL SWITCHES, RECEPTACLES, PANELBOARDS AND DISCONNECTS SHALL BE LABELED WITH SOURCE PANEL AND CIRCUIT.

16. PROVIDE FIBER BUSHINGS ON THE ENDS OF ALL CONDUIT STUBS.

INDICATED BACK TO THEIR POINT OF SOURCE. MAINTAIN (E) CIRCUIT INTEGRITY.

- 17. ALL PANELS THAT HAVE NEW CIRCUITS OR REMOVED CIRCUITS SHALL HAVE NEW TYPED UPDATED PANEL SCHEDULES.
- 19. DEMOLITION SHALL INCLUDE REMOVAL OF ALL PARTS AND PIECES IN THEIR ENTIRETY BACK TO THE POINTS INDICATED OR IF NOT

DEMOLITION NOTES

GENERAL DEMOLITION NOTES:

- 1. PRIOR TO DEMOLITION CONTRACTOR SHALL REVIEW WITH OWNER ALL MATERIALS TO BE REMOVED. SHOULD THE OWNER OPT TO KEEP ANY MATERIALS, THE CONTRACTOR SHALL REMOVE AND DELIVER THE PARTS TO THE OWNER ON THE SITE WHERE SO DIRECTED. OTHERWISE, ALL DEMOLISHED OR REMOVED MATERIALS SHALL BECOME THE PROPERTY OF THE CONTRACTOR, SHALL BE REMOVED FROM THE SITE, AND BE DISPOSED OF IN A LEGAL MANNER.
- 2. DEMOLITION SHALL INCLUDE REMOVAL OF ALL PARTS AND PIECES IN THEIR ENTIRETY BACK TO THE POINTS INDICATED OR IF NOT INDICATED BACK TO THEIR POINT OF SOURCE. WHERE CONDITIONS PROHIBIT TOTAL REMOVAL OF THE WORK, THE REMAINING PORTION SHALL BE CUT FLUSH WITH THE SURROUNDING SURFACE SHALL BE REFINISHED IN AN APPROVED MANNER.
- 3. MAINTAIN EXISTING UTILITIES INDICATED OR WHERE REQUIRED TO REMAIN, KEEP IN SERVICE, AND PROTECT AGAINST DAMAGE DURING DEMOLITION OPERATIONS. DO NOT INTERRUPT EXISTING UTILITIES SERVING OCCUPIED OR USED FACILITIES, EXCEPT WHEN SCHEDULED
- 4. DO NOT REMOVE EXISTING STRUCTURAL WORK. DO NOT REMOVE OPERATIONAL ELEMENTS AND SAFETY—RELATED COMPONENTS IN A MANNER RESULTING IN A REDUCTION OF CAPACITIES TO PERFORM IN THE MANNER INTENDED OR RESULTING IN DECREASED OPERATIONAL LIFE, INCREASED MAINTENANCE, OR DECREASED SAFETY.
- 5. REMOVALS, DISCONNECTIONS, AND RELOCATIONS SHALL BE PERFORMED BY WORKMEN SKILLED IN THE TRADE INVOLVED AND SHALL BE EMPLOYED BY A CONTRACTOR LICENSED IN THE TRADE INVOLVED. ALL WORK SHALL BE DONE IN ACCORDANCE WITH ACCEPTED TRADE PRACTICES.
- 6. PROVIDE ADEQUATE TEMPORARY SUPPORT FOR WORK TO REMAIN TO PREVENT FAILURE. DO NOT ENDANGER OTHER WORK.
- 7. PROTECTION: PROVIDE ADEQUATE PROTECTION WHERE REQUIRED FOR THE PRESENT BUILDING AND ITS CONTENTS. CONTRACTOR SHALL TAKE EVERY PRECAUTION AGAINST FIRE BY EMPLOYING FIRE DEPARTMENT TYPE HOSES AND PORTABLE FIRE EXTINGUISHERS AS REQUIRED BY OSHA AND/OR THE OWNER'S INSURANCE UNDERWRITER.
- 8. ALL EXISTING EQUIPMENT REQUIRED TO BE REUSED SHALL BE CLEANED, RECONDITIONED, CALIBRATED AND ADJUSTED. IN ALL INSTANCES WHERE CONTRACTOR FINDS THAT EXISTING EQUIPMENT IS DEFECTIVE TO THE POINT WHERE IT CANNOT BE PROPERLY RESTORED AND WILL NOT OPERATE PROPERLY, THEY SHALL REPORT THE SPECIFIC INSTRUMENTS OR EQUIPMENT TO THE ENGINEER FOR DIRECTIONS.
- 9. ALL DRAWINGS ARE DIAGRAMMATIC. CONTRACTOR SHALL CAREFULLY EXAMINE EXISTING CONDITIONS PRIOR TO STARTING WORK.
- MICROPHONE XLR JACK(S), QUANTITY OF (X), IN WALL PLATE. JACKS WITH DOUBLE GANG BACKBOX, SINGLE GANG MUD-RING AND FACEPLATE. CONTRACTOR TO INSTALL (1)PR 20GA. TWISTED SHIELDED PLENUM RATED CABLE FOR EACH JACK BACK TO AV DATA RACK LOCATION. MOUNT BACKBOX AT 18" UNLESS OTHERWISE NOTED ON THE DRAWINGS. XLR JACKS INSTALLED IN DRYWALL SHALL HAVE RECESSED DOUBLE GANG BACKBOX WITH BUSHINGS AND CABLES CONCEALED IN DRYWALL. JACKS SHOWN ON EXISTING CMU BLOCK WALLS, AND ARE NOT IN SURFACE MOUNTED DIVIDED RACEWAY, SHALL BE INSTALLED IN SINGLE CHANNEL SURFACE METALLIC RACEWAY AND SURFACE BACKBOX.
- MD STAGE MONITOR JACK(S), DEMO ONLY
- (2) TRS 1/4' STAGE MONITOR JACK(S), IN WALL PLATE WITH DOUBLE GANG BACKBOX, SINGLE GANG MUD-RING AND FACEPLATE. CONTRACTOR TO INSTALL (1) 16/2 TWISTED PLENUM RATED CABLE FOR EACH JACK BACK TO AV DATA RACK LOCATION. MOUNT BACKBOX AT 18" UNLESS OTHERWISE NOTED ON THE DRAWINGS. MONITOR JACKS INSTALLED IN DRYWALL SHALL HAVE RECESSED DOUBLE GANG BACKBOX WITH BUSHINGS AND CABLES CONCEALED IN DRYWALL. JACKS SHOWN ON EXISTING CMU BLOCK WALLS, AND ARE NOT IN SURFACE MOUNTED DIVIDED RACEWAY, SHALL BE INSTALLED IN SINGLE CHANNEL SURFACE METALLIC RACEWAY AND SURFACE BACKBOX.
- SOUND BOARD CONNECTION WITH (2) SHIELDED RJ45 JACKS IN WALL PLATE WITH DOUBLE GANG BACKBOX, SINGLE GANG MUD-RING AND FACEPLATE.

 CONTRACTOR TO INSTALL (2) CATEGORY 6A SHIELDED PLENUM RATED CABLE FOR EACH JACK BACK TO AV DATA RACK LOCATION. MOUNT BACKBOX AT 18"

 UNLESS OTHERWISE NOTED ON THE DRAWINGS. MONITOR JACKS INSTALLED IN DRYWALL SHALL HAVE RECESSED DOUBLE GANG BACKBOX WITH BUSHINGS AND CABLES CONCEALED IN DRYWALL. JACKS SHOWN ON EXISTING CMU BLOCK WALLS, AND ARE NOT IN SURFACE MOUNTED DIVIDED RACEWAY, SHALL BE INSTALLED IN SINGLE CHANNEL SURFACE METALLIC RACEWAY AND SURFACE BACKBOX.
- AVDIO VISUAL WALL PLATE INTERFACE WITH VGA, COMPOSITE AND COAX JACKS WITH DOUBLE GANG BACKBOX, DOUBLE GANG MUD-RING AND FACEPLATE.

 DEMO ONLY.

SEAL

RICHARD L. DELP, P.E.

New Jersey Professional Engineer NO. GE45368



+1(609)265-2652/-0333FAX • 21AI00912100 • RYEBREAD.COM

CONSULTANTS

SCHILLER AND HERSH ASSOCIATES, INC.
Consulting M/E/P Engineers
636 Skippack Pike, Suite 200 P: 215.886.8947
Blue Bell, PA 19422 F: 215.886.8956
S&H Job #2326A www.schillerhersh.com
Certificate of Authorization: 24GA28014000

PROJECT TITLE & ADDRESS:

AUDITORIUM RENOVATION F.W. HOLBEIN SCHOOL

BLOCK 41.05, LOT 12.09 333 LEVIS DRIVE MOUNT HOLLY NEW JERSEY 08060

OWNER ADDRESS:


MOUNT HOLLY TOWNSHIP BOE 333 LEVIS DRIVE MOUNT HOLLY NEW JERSEY 08060

OJECT 5733Δ

REVISION Addendum-01 9/26/23

DRAWING DATE:	07 AUG. 2023
PRINT DATE:	9/25/23
DRAWN BY:	JDB
SHEET TITLE:	ELECTRICAL COVER SHEET

E-001

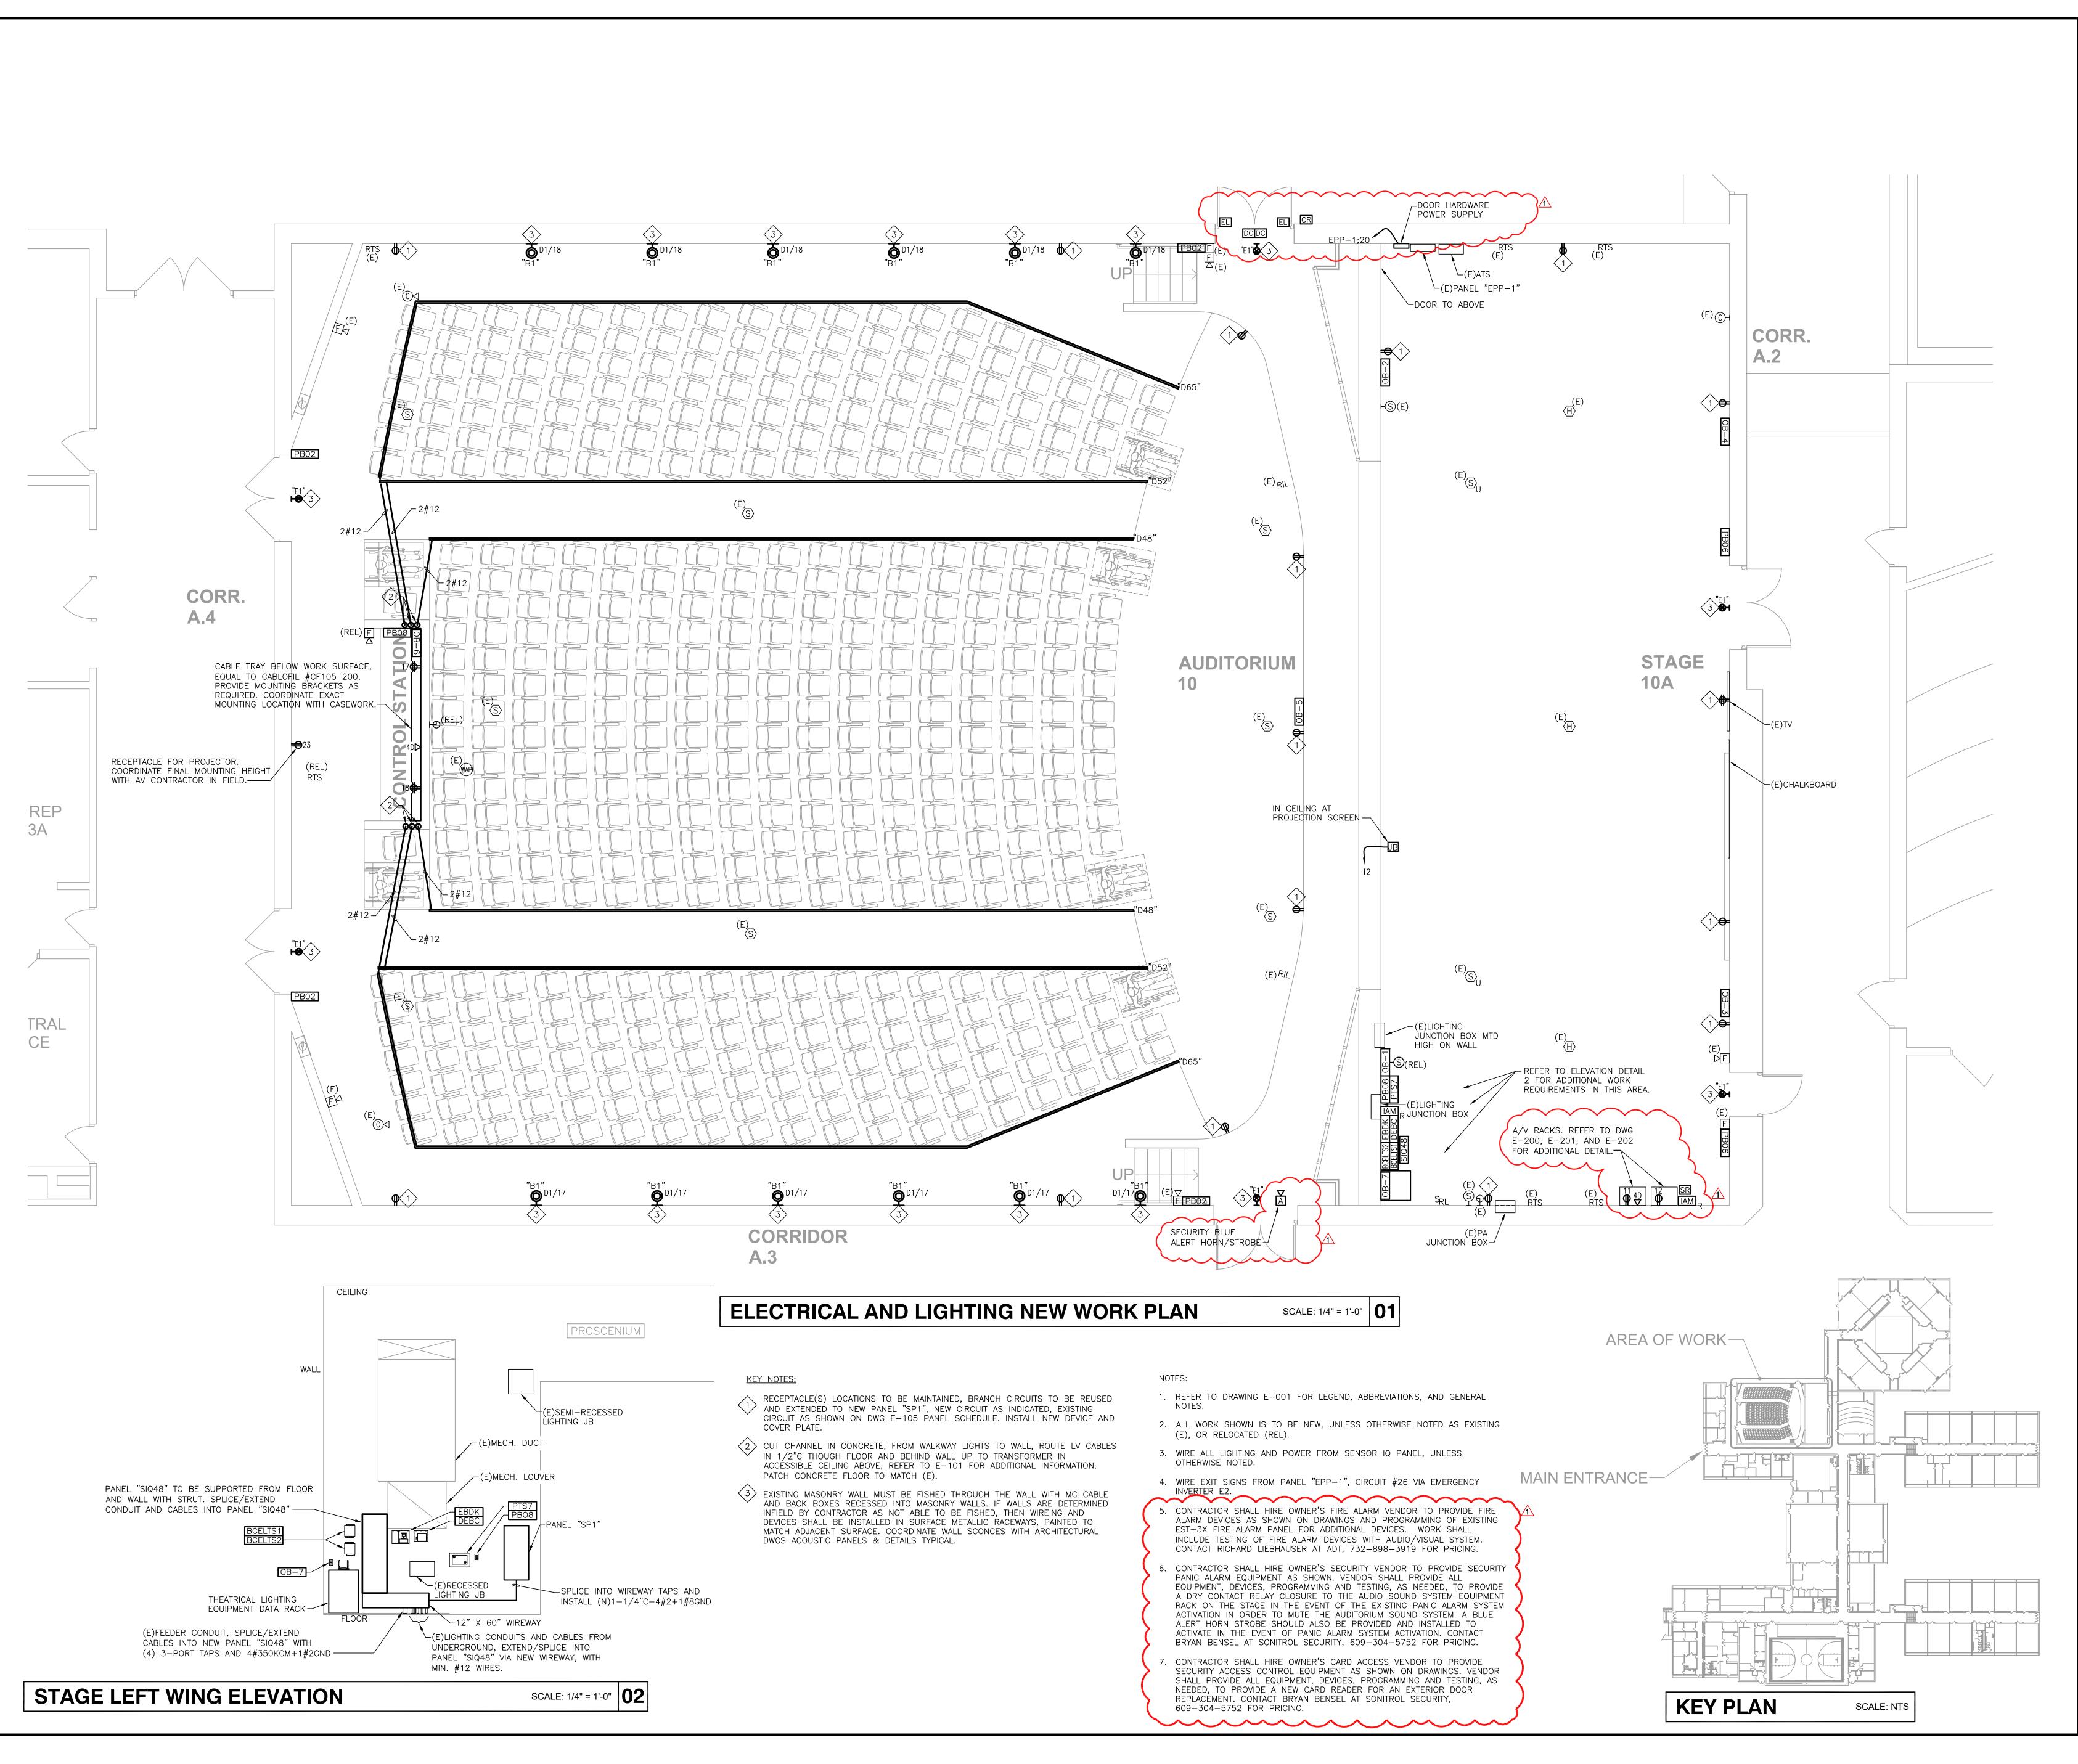

SEAL

RICHARD L. DELP, P.E.

New Jersey Professional Engineer NO. GE45368

REGAN YOUNG ENGLAND BUTERA
REFERENDUMS · ENGINEERING · ARCHITECTURE · DESIGN

456 HIGH STREET · MT. HOLLY, NEW JERSEY 08060 USA

+1(609)265-2652/-0333FAX • 21AI00912100 • RYEBREAD.COM

CONSULTANTS

SCHILLER AND HE

SCHILLER AND HERSH ASSOCIATES, INC.
Consulting M/E/P Engineers
636 Skippack Pike, Suite 200 P: 215.886.8947
Blue Bell, PA 19422 F: 215.886.8956
S&H Job #2326A www.schillerhersh.com

Certificate of Authorization: 24GA28014000

PROJECT TITLE & ADDRESS:

AUDITORIUM RENOVATION

F.W. HOLBEIN SCHOOL BLOCK 41.05, LOT 12.09 333 LEVIS DRIVE MOUNT HOLLY NEW JERSEY 08060

OWNER ADDRESS:

MOUNT HOLLY TOWNSHIP BOE 333 LEVIS DRIVE MOUNT HOLLY NEW JERSEY 08060

DJECT 5733Δ

REVISION DATE:	⚠ Addendum-01 9/26/23

	DRAWING DATE:	07 AUG. 2023
	PRINT DATE:	9/25/23
	DRAWN BY:	JDB
	SHEET TITLE:	ELECTRICAL AND LIGHTING NEW WORK PLAN

E-102